USE TYPEWRITER OR BALL POINT PEN-PRESS FIRMLY, PRINT CLEARLY.

WATER WELL RECORD
KSA 82a-1201-1215

Kansas Department of Health and Environment-Division of Environment
(Water well Contractors)
Topeka, Kansas 66620

Address #1

1. Location of well: County: Stafford | Fraction: NW¼ NW¼ NE¼ | Section number: 1 | Township number: T 21 S | Range number: R 13 E/W

2. Distance and direction from nearest town or city: Barton & Stafford Co Line
Street address of well location if in city: 2½ East

3. Owner of well: Duke Drlg.
R.R. or street:
City, state, zip code: Great Bend Ks

4. Locate with "X" in section below:

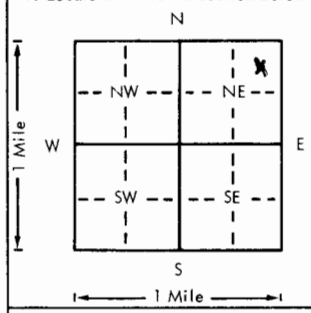

Sketch map:

6. Bore hole dia. 9 in. Completion date 6-19-78
Well depth 60 ft.

7. __ Cable tool X Rotary __ Driven __ Dug
__ Hollow rod __ Jetted __ Bored __ Reverse rotary

8. Use: __ Domestic __ Public supply __ Industry
__ Irrigation __ Air conditioning __ Stock
__ Lawn X Oil field water __ Other

9. Casing: Material PVC Height: Above or below
Threaded __ Welded X Surface 12 in.
RMP __ PVC __ Weight 287.3 lbs./ft.
Dia. 5 in. to 60 ft. depth Wall Thickness: inches or
Dia. __ in. to __ ft. depth gage No. 200

5. Type and color of material	From	To
Clay & Fine Sand	0	18
Fine Sand &	18	25
Sandy Clay		
Clay. Sandy	25	40
Gravel	40	60

(Use a second sheet if needed)

10. Screen: Manufacturer's name Shop made
Type Saw Dia. 5
Slot/gauze 18 Length 20
Set between 40 ft. and 60 ft.
ft. and ft.
Gravel pack? X Size range of material 4-8

11. Static water level: mo./day/yr.
18 ft. below land surface Date 6-19-78

12. Pumping level below land surfaces:
ft. after hrs. pumping g.p.m.
ft. after hrs. pumping g.p.m.
Estimated maximum yield g.p.m.

13. Water sample submitted: mo./day/yr.
__ Yes __ No Date

14. Well head completion:
__ Pitless adapter 12 Inches above grade

15. Well grouted? X
With: __ Neat cement X Bentonite X Concrete
Depth: From 0 ft. to 24 ft.

16. Nearest source of possible contamination:
ft. Direction Type
Well disinfected upon completion? __ Yes __ No

17. Pump: X Not installed
Manufacturer's name
Model number HP Volts
Length of drop pipe ft. capacity g.p.m.
Type:
__ Submersible __ Turbine
__ Jet __ Reciprocating
__ Centrifugal __ Other

18. Elevation:

Topography:
__ Hill
X Slope
__ Upland
__ Valley

19. Remarks:

20. Water well contractor's certification:
This well was drilled under my jurisdiction and this report is true to the best of my knowledge and belief.
Myers Water Well 143
Business name License No.
Address 6th Bend Ks
Signed Lloyd Rounds Date 6-19-78
Authorized representative

21 T - 13 R E/W - 1 Sec - NW 1/4 - NW 1/4 - NE 1/4

Forward the white, blue and pink copies to the Department of Health and Environment

Form WWC-5

MI-1023