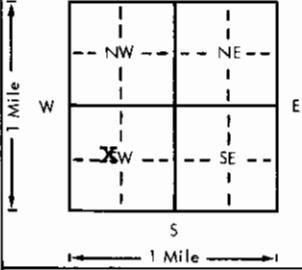


USE TYPEWRITER OR BALL POINT PEN-PRESS FIRMLY, PRINT CLEARLY.

WATER WELL RECORD  
KSA 82a-1201-1215

Kansas Department of Health and Environment-Division of Environment (Water well Contractors)  
Topeka, Kansas 66620

1. Location of well:		County <b>Stafford</b>	Fraction 1/4 <b>CSW</b> 1/4	Section number <b>5</b>	Township number T <b>21</b> S	Range number R <b>13W</b> E/W
2. Distance and direction from nearest town or city: Street address of well location if in city: <b>4 1/2 N/E Seward, Kan.</b>				3. Owner of <b>Fred Newcombe</b> R.R. or street: <b>Brt. 2</b> City, state, zip code: <b>Great Bend Ks. 67530</b>		
4. Locate with "X" in section below: Sketch map: 				6. Bore hole dia. <b>8</b> in. Completion date <b>7-9-77</b> Well depth <b>77</b> ft.		
				7. <input checked="" type="checkbox"/> Cable tool <input checked="" type="checkbox"/> Rotary <input type="checkbox"/> Driven <input type="checkbox"/> Dug <input type="checkbox"/> Hollow rod <input type="checkbox"/> Jetted <input type="checkbox"/> Bored <input type="checkbox"/> Reverse rotary		
				8. Use: <input checked="" type="checkbox"/> Domestic <input checked="" type="checkbox"/> Public supply <input type="checkbox"/> Industry <input type="checkbox"/> Irrigation <input type="checkbox"/> Air conditioning <input type="checkbox"/> Stock <input type="checkbox"/> Lawn <input type="checkbox"/> Oil field water <input type="checkbox"/> Other		
				9. Casing: Material <b>PVC</b> Height: Above <b>12</b> in. Threaded <input type="checkbox"/> Welded <input type="checkbox"/> Surface <b>12</b> in. RMP <input type="checkbox"/> PVC <input checked="" type="checkbox"/> Weight _____ lbs./ft. Dia. _____ in. to _____ ft. depth Wall thickness _____ inch Dia. _____ in. to _____ ft. depth gage No. <b>sch 40</b>		
5. Type and color of material		<b>Top Soil-Clay</b>		From <b>0</b>	To <b>23</b>	
		<b>Sand</b>		<b>23</b>	<b>32</b>	
		<b>Clay</b>		<b>32</b>	<b>53</b>	
		<b>Sand-Gravel</b>		<b>53</b>	<b>77</b>	
				10. Screen: Manufacturer's name <b>MPI</b> Type <b>PVC</b> Dia. <b>5"</b> Slot/gauze <b>1/16"</b> Length <b>20'</b> Set between <b>57</b> ft. and <b>77</b> ft. Set between _____ ft. and _____ ft. Gravel pack? <input checked="" type="checkbox"/> Size range of material <b>1/8-3/4"</b>		
				11. Static water level: <b>18'</b> ft. below land surface Date <b>7-7-77</b> mo./day/yr.		
				12. Pumping level below land surfaces: _____ ft. after _____ hrs. pumping _____ g.p.m. _____ ft. after _____ hrs. pumping _____ g.p.m. Estimated maximum yield <b>60</b> g.p.m.		
				13. Water sample submitted: _____ mo./day/yr. <input type="checkbox"/> Yes <input checked="" type="checkbox"/> No Date _____		
				14. Well head completion: <b>12</b> inches above grade <input type="checkbox"/> Pitless adapter		
				15. Well grouted? <input checked="" type="checkbox"/> With: <input type="checkbox"/> Neat cement <input checked="" type="checkbox"/> Bentonite <input type="checkbox"/> Concrete Depth: From <b>0</b> ft. to <b>10</b> ft.		
				16. Nearest source of possible contamination: <b>sewer</b> ft. <b>30</b> Direction <b>se</b> Type <b>sewer</b> Well disinfected upon completion? <input checked="" type="checkbox"/> Yes <input type="checkbox"/> No		
				17. Pump: <input checked="" type="checkbox"/> Not installed Manufacturer's name _____ Model number _____ HP _____ Volts _____ Length of drop pipe _____ ft. capacity _____ g.p.m. Type: <input type="checkbox"/> Submersible <input type="checkbox"/> Turbine <input type="checkbox"/> Jet <input type="checkbox"/> Reciprocating <input type="checkbox"/> Centrifugal <input type="checkbox"/> Other		
(Use a second sheet if needed)						
18. Elevation:		19. Remarks:				
Topography: <input type="checkbox"/> Hill <input type="checkbox"/> Slope <input checked="" type="checkbox"/> Upland <input type="checkbox"/> Valley						
20. Water well contractor's certification: This well was drilled under my jurisdiction and this report is true to the best of my knowledge and belief. <b>Kelly's Waterwell Ser. 186</b> Business name _____ License No. _____ Address <b>Rt. 2 Great Bend, Ks.</b> Signed <b>Kelly Prisel</b> Date <b>9-10-77</b> Authorized representative						

Forward the white, blue and pink copies to the Department of Health and Environment

Form WWC-5