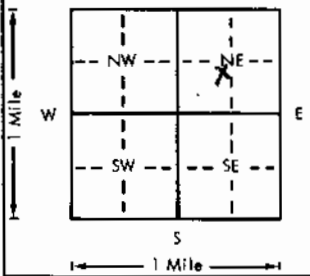


USE TYPEWRITER OR BALL POINT PEN-PRESS FIRMLY, PRINT CLEARLY.

WATER WELL RECORD
KSA 82a-1201-1215

Kansas Department of Health and Environment-Division of Environment
(Water well Contractors)
Topeka, Kansas 66620

Nixon #1

1. Location of well: County <i>Stafford</i> Fraction <i>NE 1/4 SW 1/4 NE 1/4</i> Section number <i>21</i> Township number <i>21</i> Range number <i>13</i>	
2. Distance and direction from nearest town or city: <i>9 South</i> Street address of well location if in city: <i>1/2 east of St Bend</i> 3. Owner of well: <i>Dupe Drilling</i> R.R. or street: <i>Great Bend Kans.</i> City, state, zip code: <i>Great Bend Kans.</i>	
4. Locate with "X" in section below: Sketch map: 	
5. Type and color of material	
	From To
<i>Clay</i>	<i>0 10</i>
<i>Sand</i>	<i>10 24</i>
<i>Gravel</i>	<i>24 35</i>
6. Bore hole dia. <i>5</i> in. Completion date <i>10-25-75</i> Well depth <i>35</i> ft.	
7. <input type="checkbox"/> Cable tool <input checked="" type="checkbox"/> Rotary <input type="checkbox"/> Driven <input type="checkbox"/> Dug <input type="checkbox"/> Hollow rod <input type="checkbox"/> Jetted <input type="checkbox"/> Bored <input type="checkbox"/> Reverse rotary	
8. Use: <input type="checkbox"/> Domestic <input type="checkbox"/> Public supply <input type="checkbox"/> Industry <input type="checkbox"/> Irrigation <input type="checkbox"/> Air conditioning <input type="checkbox"/> Stock <input type="checkbox"/> Lawn <input checked="" type="checkbox"/> Oil field water <input type="checkbox"/> Other	
9. Casing: Material <i>Steel</i> Weight: <i>Above</i> or below Threaded <input type="checkbox"/> Welded <input checked="" type="checkbox"/> Surface <i>12</i> in. RMP <input type="checkbox"/> PVC <input checked="" type="checkbox"/> Weight <i>53</i> lbs./ft. Dia. <i>2</i> in. to <i>35</i> ft. depth Wall Thickness: inches or Dia. <i>2</i> in. to <i>35</i> ft. depth gage No. <i>200</i>	
10. Screen: Manufacturer's name <i>Reynolds Plastic</i> Type <i>PVC</i> Dia. <i>2</i> Slot/gauze <i>5/8</i> Length <i>10</i> Set between <i>25</i> ft. and <i>35</i> ft. Gravel pack? <i>yes</i> Size range of material <i>1/8 - 1/4</i>	
11. Static water level: <i>12</i> ft. below land surface Date <i>10-25-75</i> mo./day/yr.	
12. Pumping level below land surfaces: ____ ft. after ____ hrs. pumping ____ g.p.m. ____ ft. after ____ hrs. pumping ____ g.p.m. Estimated maximum yield ____ g.p.m.	
13. Water sample submitted: ____ mo./day/yr. Yes <input checked="" type="checkbox"/> No <input type="checkbox"/> Date ____	
14. Well head completion: <input type="checkbox"/> Pitless adapter <i>12</i> inches above grade	
15. Well grouted? <i>yes</i> With: <input type="checkbox"/> Neat cement <input checked="" type="checkbox"/> Bentonite <input type="checkbox"/> Concrete Depth: From <i>0</i> ft. to <i>12</i> ft.	
16. Nearest source of possible contamination: <i>Well</i> ft. ____ Direction ____ Type ____ Well disinfected upon completion? <input type="checkbox"/> Yes <input checked="" type="checkbox"/> No	
17. Pump: <input checked="" type="checkbox"/> Not installed Manufacturer's name ____ Model number ____ HP ____ Volts ____ Length of drop pipe ____ ft. capacity ____ g.p.m. Type: <input type="checkbox"/> Submersible <input type="checkbox"/> Turbine <input type="checkbox"/> Jet <input type="checkbox"/> Reciprocating <input type="checkbox"/> Centrifugal <input type="checkbox"/> Other	
(Use a second sheet if needed)	
18. Elevation: Topography: <input type="checkbox"/> Hill <input checked="" type="checkbox"/> Slope <input type="checkbox"/> Upland <input type="checkbox"/> Valley	19. Remarks: 20. Water well contractor's certification: This well was drilled under my jurisdiction and this report is true to the best of my knowledge and belief. <i>Myers Water Well 1431</i> Business name <i>Great Bend Ks</i> License No. ____ Address <i>Great Bend Ks</i> Signed <i>Arfred A Myers</i> date <i>10-25-75</i> Authorized representative

21
 13
 W
 11
 Sec
 PRESERVE

Forward the white, blue and pink copies to the Department of Health and Environment

Form WWC-5