


1 LOCATION OF WATER WELL:	Fraction	Section Number	Township Number	Range Number
County: Stafford	C E/2 1/4 NE 1/4 SW 1/4	17	T 21 S	R 13W EW

Distance and direction from nearest town or city street address of well if located within city?
Jct 281 & Barton/Stafford Co. line, 2 S, 2 W, 1/2 S, E into

2 WATER WELL OWNER:	White & Ellis Drilling, Inc.	Board of Agriculture, Division of Water Resources
RR#, St. Address, Box # :	P. O. Box 1586	Application Number: T84-516
City, State, ZIP Code :	Great Bend, KS 67530	

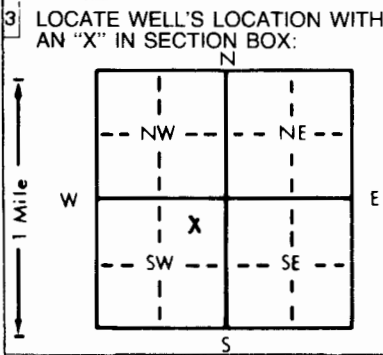

4 DEPTH OF COMPLETED WELL: 80 ft.	ELEVATION:
Depth(s) Groundwater Encountered 1. ft. 2. ft. 3. ft.	
WELL'S STATIC WATER LEVEL ft. below land surface measured on mo/day/yr	
Pump test data: Well water was ft. after hours pumping gpm	
Est. Yield gpm: Well water was ft. after hours pumping gpm	
Bore Hole Diameter in. to ft., and in. to ft.	
WELL WATER TO BE USED AS:	
1 Domestic 3 Feedlot 6 Oil field water supply 9 Dewatering 12 Other (Specify below)	
2 Irrigation 4 Industrial 7 Lawn and garden only 10 Observation well	
Was a chemical/bacteriological sample submitted to Department? Yes.....No.....; If yes, mo/day/yr sample was submitted	
Water Well Disinfected? Yes No	

5 TYPE OF BLANK CASING USED:	5 Wrought iron	8 Concrete tile	CASING JOINTS: Glued Clamped
1 Steel 3 RMP (SR)	6 Asbestos-Cement	9 Other (specify below)	Welded
2 PVC 4 ABS	7 Fiberglass		Threaded
Blank casing diameter in. to ft., Dia in. to ft., Dia in. to ft.			
Casing height above land surface in., weight lbs./ft. Wall thickness or gauge No.			
TYPE OF SCREEN OR PERFORATION MATERIAL:	7 PVC	10 Asbestos-cement	
1 Steel 3 Stainless steel 5 Fiberglass 8 RMP (SR) 11 Other (specify)			
2 Brass 4 Galvanized steel 6 Concrete tile 9 ABS 12 None used (open hole)			
SCREEN OR PERFORATION OPENINGS ARE:	5 Gauzed wrapped	8 Saw cut	11 None (open hole)
1 Continuous slot 3 Mill slot 6 Wire wrapped 9 Drilled holes			
2 Louvered shutter 4 Key punched 7 Torch cut 10 Other (specify)			
SCREEN-PERFORATED INTERVALS: From ft. to ft., From ft. to ft.			
GRAVEL PACK INTERVALS: From ft. to ft., From ft. to ft.			

6 GROUT MATERIAL:	1 Neat cement	2 Cement grout	3 Bentonite	4 Other
Grout Intervals: From ft. to ft., From ft. to ft., From ft. to ft.				
What is the nearest source of possible contamination:	10 Livestock pens	14 Abandoned water well		
1 Septic tank 4 Lateral lines 7 Pit privy 11 Fuel storage 15 Oil well/Gas well				
2 Sewer lines 5 Cess pool 8 Sewage lagoon 12 Fertilizer storage 16 Other (specify below)				
3 Watertight sewer lines 6 Seepage pit 9 Feedyard 13 Insecticide storage				
Direction from well? How many feet?				

FROM	TO	LITHOLOGIC LOG	FROM	TO	LITHOLOGIC LOG
		Placed 5 sks cement in hole			

7 CONTRACTOR'S OR LANDOWNER'S CERTIFICATION: This water well was (1) constructed, (2) reconstructed, or (3) plugged under my jurisdiction and was completed on (mo/day/year) **8/30/84** and this record is true to the best of my knowledge and belief. Kansas Water Well Contractor's License No. This Water Well Record was completed on (mo/day/yr) **8/30/84** under the business name of **White & Ellis Drilling, Inc.** by (signature) *Dudith A. Struben*

INSTRUCTIONS: Use typewriter or ball point pen, PLEASE PRESS FIRMLY and PRINT clearly. Please fill in blanks, underline or circle the correct answers. Send top three copies to Kansas Department of Health and Environment, Division of Environment, Environmental Geology Section, Topeka, KS 66620. Send one to WATER WELL