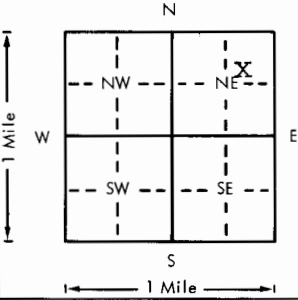


USE TYPEWRITER OR BALL POINT PEN-PRESS FIRMLY, PRINT CLEARLY.

WATER WELL RECORD
KSA 82a-1201-1215

Kansas Department of Health and Environment-Division of Environment
(Water well Contractors)
Topeka, Kansas 66620

1. Location of well:		County Stafford	Fraction sw 1/4 ne 1/4 ne 1/4	Section number 20	Township number T 21 S R	Range number 13w E/W
2. Distance and direction from nearest town or city: Street address of well location if in city:			3. Owner of well: Woodman-Ianniti Drig. Co. R.R. or street: Box 308 City, state, zip code: Great Bend, Ks. 67530			
4. Locate with "X" in section below: Sketch map: 			6. Bore hole dia. 5 1/2 in. Completion date 7-23-77 Well depth 50 ft.			7. <input type="checkbox"/> Cable tool <input checked="" type="checkbox"/> Rotary <input type="checkbox"/> Driven <input type="checkbox"/> Dug <input type="checkbox"/> Hollow rod <input type="checkbox"/> Jetted <input type="checkbox"/> Bored <input type="checkbox"/> Reverse rotary
5. Type and color of material			8. Use: <input type="checkbox"/> Domestic <input type="checkbox"/> Public supply <input type="checkbox"/> Industry <input type="checkbox"/> Irrigation <input type="checkbox"/> Air conditioning <input type="checkbox"/> Stock <input type="checkbox"/> Lawn <input checked="" type="checkbox"/> Oil field water <input type="checkbox"/> Other			9. Casing: Material <input type="checkbox"/> Height: Above <input checked="" type="checkbox"/> XXXX Threaded <input type="checkbox"/> Welded <input type="checkbox"/> Surface 12 in. RMP <input type="checkbox"/> PVC <input checked="" type="checkbox"/> Weight <input type="checkbox"/> lbs./ft. Dia. 2 in. to 50 ft. depth Wall Thickness inches or Dia. <input type="checkbox"/> in. to <input type="checkbox"/> ft. depth gage No. Sch 40
			10. Screen: Manufacturer's name MPI Type PVB Dia. 2" Slot/gauze 1/16 Length 20" Set between 30 ft. and 50 ft. Gravel pack? <input checked="" type="checkbox"/> Size range of material 1/8-3/4"			
			11. Static water level: <input type="checkbox"/> mo./day/yr. 12 ft. below land surface Date 7-34-77			
			12. Pumping level below land surfaces: <input type="checkbox"/> ft. after <input type="checkbox"/> hrs. pumping <input type="checkbox"/> g.p.m. <input type="checkbox"/> ft. after <input type="checkbox"/> hrs. pumping <input type="checkbox"/> g.p.m. Estimated maximum yield 50 g.p.m.			
			13. Water sample submitted: <input type="checkbox"/> mo./day/yr. Yes <input checked="" type="checkbox"/> No Date			
			14. Well head completion: <input type="checkbox"/> Pitless adapter 12 Inches above grade			
			15. Well grouted? <input checked="" type="checkbox"/> With: <input type="checkbox"/> Neat cement <input checked="" type="checkbox"/> Bentonite <input type="checkbox"/> Concrete Depth: From 0 ft. to 10 ft.			
			16. Nearest source of possible contamination: oil test ft. 60 Direction se Type test Well disinfected upon completion? <input type="checkbox"/> Yes <input checked="" type="checkbox"/> No			
			17. Pump: <input checked="" type="checkbox"/> Not installed Manufacturer's name Model number <input type="checkbox"/> HP <input type="checkbox"/> Volts <input type="checkbox"/> Length of drop pipe <input type="checkbox"/> ft. capacity <input type="checkbox"/> g.p.m. Type: <input type="checkbox"/> Submersible <input type="checkbox"/> Turbine <input type="checkbox"/> Jet <input type="checkbox"/> Reciprocating <input type="checkbox"/> Centrifugal <input type="checkbox"/> Other			
			(Use a second sheet if needed)			
18. Elevation:		19. Remarks:		20. Water well contractor's certification: This well was drilled under my jurisdiction and this report is true to the best of my knowledge and belief. Kelly's Waterwell Ser 186 Business name License No. Address R2 Great Bend, Ks. Signed Kelly Price Date 10-10-78 Authorized representative		
Topography: <input type="checkbox"/> Hill <input type="checkbox"/> Slope <input checked="" type="checkbox"/> Upland <input type="checkbox"/> Valley						

21
130
20
SW NE NE
1/4
1/4
1/4