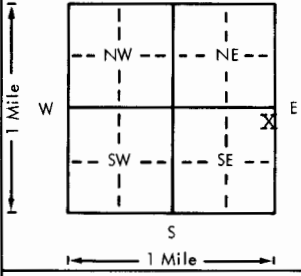


USE TYPEWRITER OR BALL POINT PEN-PRESS FIRMLY, PRINT CLEARLY.

WATER WELL RECORD
KSA 82a-1201-1215

Kansas Department of Health and Environment-Division of Environment
(Water well Contractors)
Topeka, Kansas 66620

1. Location of well:		County Stafford	Fraction ne 1/4 ne 1/4 ## 1/4 ^{se}	Section number 31	Township number T 21	Range number S R 13w	E/W E/W
2. Distance and direction from nearest town or city: Street address of well location if in city: 1/4 e Seward, Ks.			3. Owner of well: D. T. Dennis R.R. or street: 1204 Frey City, state, zip code: Great Bend, Ks.				
4. Locate with "X" in section below: Sketch map: 			6. Bore hole dia. 8 in. Completion date 5-2-78 Well depth 68 ft.				
5. Type and color of material			From		To		7. <input type="checkbox"/> Cable tool <input checked="" type="checkbox"/> Rotary <input type="checkbox"/> Driven <input type="checkbox"/> Dug <input type="checkbox"/> Hollow rod <input type="checkbox"/> Jetted <input type="checkbox"/> Bored <input type="checkbox"/> Reverse rotary
			Top Soil-Clay *		0	25	8. Use: <input checked="" type="checkbox"/> Domestic <input type="checkbox"/> Public supply <input type="checkbox"/> Industry <input type="checkbox"/> Irrigation <input type="checkbox"/> Air conditioning <input type="checkbox"/> Stock <input type="checkbox"/> Lawn <input type="checkbox"/> Oil field water <input type="checkbox"/> Other
			Sand-Clay		25	40	9. Casing: Material _____ Height: Above at XXXX Threaded _____ Welded _____ Surface 12 in. RMP _____ PVC <input checked="" type="checkbox"/> Weight 2.8 lbs./ft. Dia. 5 in. to 68 ft. depth Wall Thickness, inches or Dia. _____ in. to _____ ft. depth Gage No. Sch 40
Sand-Gravel		40	68	10. Screen: Manufacturer's name Jetstream Type pvc Dia. 5" Slot/gauze 1/32" Length 20' Set between 48 ft. and 68 ft. _____ ft. and _____ ft. Gravel pack? <input checked="" type="checkbox"/> Size range of material 1/8-3/4"			
					11. Static water level: _____ mo./day/yr. 18 ft. below land surface Date 5-2-78		
					12. Pumping level below land surfaces: _____ ft. after _____ hrs. pumping _____ g.p.m. _____ ft. after _____ hrs. pumping _____ g.p.m. Estimated maximum yield 50 g.p.m.		
					13. Water sample submitted: _____ mo./day/yr. Yes <input checked="" type="checkbox"/> No <input type="checkbox"/> Date _____		
					14. Well head completion: <input type="checkbox"/> Pitless adapter 12 Inches above grade		
					15. Well grouted? <input checked="" type="checkbox"/> With: <input checked="" type="checkbox"/> Neat cement <input type="checkbox"/> Bentonite <input type="checkbox"/> Concrete Depth: From 0 ft. to 10 ft.		
					16. Nearest source of possible contamination: ft. 70 Direction nw Type sewer Well disinfected upon completion? <input checked="" type="checkbox"/> Yes <input type="checkbox"/> No		
					17. Pump: <input checked="" type="checkbox"/> Not installed Manufacturer's name _____ Model number _____ HP _____ Volts _____ Length of drop pipe _____ ft. capacity _____ g.p.m. Type: <input type="checkbox"/> Submersible <input type="checkbox"/> Turbine <input type="checkbox"/> Jet <input type="checkbox"/> Reciprocating <input type="checkbox"/> Centrifugal <input type="checkbox"/> Other		
			(Use a second sheet if needed)				
18. Elevation: Topography: <input type="checkbox"/> Hill <input type="checkbox"/> Slope <input checked="" type="checkbox"/> Upland <input type="checkbox"/> Valley	19. Remarks:		20. Water well contractor's certification: This well was drilled under my jurisdiction and this report is true to the best of my knowledge and belief. Kellys Waterwell Ser 186 Business name _____ License No. _____ Address R2 Great Bend, Ks. Signed Kelly Price Date 9-28 Authorized Representative				

T
R
S
1/4
1/4
1/4
1/4
NE
SE