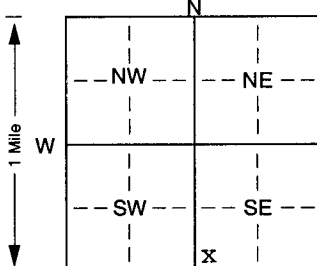


1 LOCATION OF WATER WELL:		Fraction	Section Number		Township Number		Range Number	
County: Stafford		SW 1/4 SW 1/4 SE 1/4	17		T 21 S		R 14 E/W	
Distance and direction from nearest town or city street address of well if located within city? Approximately 3 miles north and 1/2 mile east of Radium								
2 WATER WELL OWNER: Don Kirman			Board of Agriculture, Division of Water Resources					
RR#, St. Address, Box #: P.O. Box 368			Application Number:					
City, State, ZIP Code: Great Bend, KS 67530								
3 LOCATE WELL'S LOCATION WITH AN "X" IN SECTION BOX:			4 DEPTH OF COMPLETED WELL: 54 ft. ELEVATION: unknown					
			Depth(s) Groundwater Encountered 1. ft. 2. ft. 3. ft. WELL'S STATIC WATER LEVEL 30.72 ft. below land surface measured on mo/day/yr 8-1-00 Pump test data: Well water was not ch'd. ft. after hours pumping gpm Est. Yield unknown gpm: Well water was ft. after hours pumping gpm Bore Hole Diameter 8 in. to 55 ft. and in. to ft. WELL WATER TO BE USED AS: 5 Public water supply 8 Air conditioning 11 Injection well 1 Domestic 3 Feedlot 6 Oil field water supply 9 Dewatering 12 Other (Specify below) 2 Irrigation 4 Industrial 7 Domestic (lawn & garden) 10 Monitoring well Stock Well Was a chemical/bacteriological sample submitted to Department? Yes. No. X; If yes, mo/day/yr sample was submitted Water Well Disinfected? Yes X No					
5 TYPE OF BLANK CASING USED:			CASING JOINTS: Glued. X. Clamped.					
1 Steel 3 RMP (SR) 6 Asbestos-Cement 9 Other (specify below) Welded								
2 PVC 4 ABS 7 Fiberglass Threaded								
Blank casing diameter 5 in. to 42 ft. Dia. in. to ft. Dia. in. to ft.								
Casing height above land surface 24 in., weight 2.36 lbs./ft. Wall thickness or gauge No. 214								
TYPE OF SCREEN OR PERFORATION MATERIAL:			7 PVC 10 Asbestos-cement					
1 Steel 3 Stainless steel 5 Fiberglass 8 RMP (SR) 11 Other (specify)								
2 Brass 4 Galvanized steel 6 Concrete tile 9 ABS 12 None used (open hole)								
SCREEN OR PERFORATION OPENINGS ARE:			5 Gauzed wrapped 8 Saw cut 11 None (open hole)					
1 Continuous slot 3 Mill slot 6 Wire wrapped 9 Drilled holes								
2 Louvered shutter 4 Key punched 7 Torch cut 10 Other (specify) ft.								
SCREEN-PERFORATED INTERVALS: From 42 ft. to 52 ft. From ft. to ft.								
GRAVEL PACK INTERVALS: From 24 ft. to 29 ft. From ft. to ft.								
From 32 ft. to 52 ft. From ft. to ft.								
6 GROUT MATERIAL: Soil 1 Neat cement 2 Cement grout 3 Bentonite 4 Other Bentonite Holeplug								
Grout Intervals: From 0 ft. to 4 ft. From 4 ft. to 24 ft. From 29 ft. to 32 ft.								
What is the nearest source of possible contamination:			10 Livestock pens 14 Abandoned water well					
1 Septic tank 4 Lateral lines 7 Pit privy 11 Fuel storage 15 Oil well/Gas well								
2 Sewer lines 5 Cess pool 8 Sewage lagoon 12 Fertilizer storage 16 Other (specify below)								
3 Watertight sewer lines 6 Seepage pit 9 Feedyard 13 Insecticide storage None known								
Direction from well?			How many feet?					
FROM	TO	LITHOLOGIC LOG	FROM	TO	PLUGGING INTERVALS			
0	5	Sand, topsoil						
5	14	Clay, brown						
14	17	Sand, fine (drift)						
17	21	Clay, brown						
21	25	Clay, light brown, sandy						
25	32	Sand and gravel with clay streaks, brown, sandy						
32	40	Sand and gravel with clay streaks, brown and gray						
40	52	Sand and gravel, coarse, medium, and fine						
52	55	Clay, yellowish brown						
7 CONTRACTOR'S OR LANDOWNER'S CERTIFICATION: This water well was (1) constructed, (2) reconstructed, or (3) plugged under my jurisdiction and was completed on (mo/day/year) 8-1-00 and this record is true to the best of my knowledge and belief. Kansas Water Well Contractor's Licence No. 185 This Water Well Record was completed on (mo/day/yr) 8-2-00 under the business name of Clarke Well & Equipment, Inc. by (signature)								