


1 LOCATION OF WATER WELL:	Fraction	Section Number	Township Number	Range Number
County: <b>Stafford</b>	<b>SE ¼ SW ¼ SW ¼</b>	<b>8</b>	<b>T 21 S</b>	<b>R 14w E/W</b>

Distance and direction from nearest town or city street address of well if located within city?  
**4N of Radium, Ks.**

2 WATER WELL OWNER: <b>John Drew</b>	<b>Sterling Drilling Co.</b>	Board of Agriculture, Division of Water Resources
RR#, St. Address, Box # : <b>1219 Stone St.</b>	<b>P. O. Box 1006</b>	Application Number: <b>20020144</b>
City, State, ZIP Code : <b>Great Bend, Ks. 67530</b>	<b>Pratt, Ks. 67124</b>	

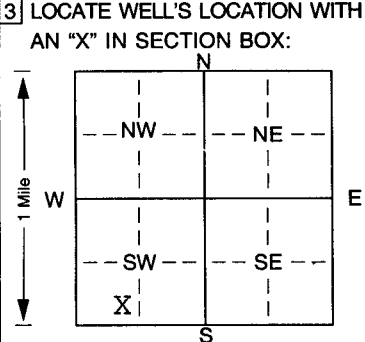

4 DEPTH OF COMPLETED WELL... **85** ft. ELEVATION: ... **unknown**

Depth(s) Groundwater Encountered 1... **30** ft. 2... ft. 3... ft.

WELL'S STATIC WATER LEVEL... **30** ft. below land surface measured on mo/day/yr **08/20/02**

Pump test data: Well water was ... ft. after ... hours pumping ... gpm

Est. Yield .. **50** gpm: Well water was ... ft. after ... hours pumping ... gpm

Bore Hole Diameter... **8** in. to **85** ft., and... in. to ... ft.

WELL WATER TO BE USED AS:

5 Public water supply	8 Air conditioning	11 Injection well
1 Domestic	3 Feedlot	6 Oil field water supply
2 Irrigation	4 Industrial	7 Domestic (lawn & garden)
		9 Dewatering
		10 Monitoring well
		12 Other (Specify below)

Was a chemical/bacteriological sample submitted to Department? Yes. .... No. .... ; If yes, mo/day/yrs sample was submitted

Water Well Disinfected? Yes No

5 TYPE OF BLANK CASING USED:

1 Steel	3 RMP (SR)	6 Asbestos-Cement	9 Other (specify below)	CASING JOINTS: <u>Glued</u> Clamped
2 PVC	4 ABS	7 Fiberglass		Welded
				Threaded

Blank casing diameter ... **5** in. to **65** ft., Dia ... in. to ... ft., Dia ... in. to ... ft.

Casing height above land surface... **12** in., weight ... **2.8** lbs./ft. Wall thickness or gauge No. **Sch. 40**

TYPE OF SCREEN OR PERFORATION MATERIAL:

1 Steel	3 Stainless steel	5 Fiberglass	<u>7 PVC</u>	10 Asbestos-cement
2 Brass	4 Galvanized steel	6 Concrete tile	8 RMP (SR)	11 Other (specify)
			9 ABS	12 None used (open hole)

SCREEN OR PERFORATION OPENINGS ARE:

1 Continuous slot	3 Mill slot	5 Gauzed wrapped	<u>8 Saw cut</u>	11 None (open hole)
2 Louvered shutter	4 Key punched	6 Wire wrapped	9 Drilled holes	
		7 Torch cut	10 Other (specify)	ft.

SCREEN-PERFORATED INTERVALS: From... **65** ft. to **85** ft., From ... ft. to ... ft.

GRAVEL PACK INTERVALS: From... **20** ft. to **85** ft., From ... ft. to ... ft.

6 GROUT MATERIAL: 1 Neat cement 2 Cement grout 3 Bentonite 4 Other

Grout Intervals: From... **0** ft. to **20** ft., From ... ft. to ... ft., From ... ft. to ... ft.

What is the nearest source of possible contamination:

1 Septic tank	4 Lateral lines	7 Pit privy	10 Livestock pens	14 Abandoned water well
2 Sewer lines	5 Cess pool	8 Sewage lagoon	11 Fuel storage	<u>15 Oil well/Gas well</u>
3 Watertight sewer lines	6 Seepage pit	9 Feedyard	12 Fertilizer storage	16 Other (specify below)
			13 Insecticide storage	

Direction from well? **North** How many feet? **110**

FROM	TO	LITHOLOGIC LOG	FROM	TO	PLUGGING INTERVALS
0	3	top soil			
3	21	clay			
21	60	fine sand			
60	85	sand and gravel			

7 CONTRACTOR'S OR LANDOWNER'S CERTIFICATION: This water well was (1) constructed, (2) reconstructed, or (3) plugged under my jurisdiction and was completed on (mo/day/year) ... **08/20/02** ... and this record is true to the best of my knowledge and belief. Kansas Water Well Contractor's Licence No. ... **186** ... This Water Well Record was completed on (mo/day/yr) ... **09/03/02** ... under the business name of **Kelly's Water Well Service, Inc.** by (signature) *Kathryn L. Wood*