


1 LOCATION OF WATER WELL:		Fraction	Section Number	Township Number	Range Number
County: <u>Stafford</u>		SE 1/4 NW 1/4 NW 1/4	17	T 21 S	R 14w E/W

Range Number
R 14W EAW

2	WATER WELL OWNER: Madeline Osborne	Sterling Drilling Company	Osborne #1-17
	RR#, St. Address, Box # : 3128 Shore Drive	P. O. Box 1006	Board of Agriculture, Division of Water Resource
	City, State, ZIP Code : Grove, OK 74344	Pratt, Ks. 67124	Application Number: 20020196

4 DEPTH OF COMPLETED WELL 77 ft. ELEVATION: unknown

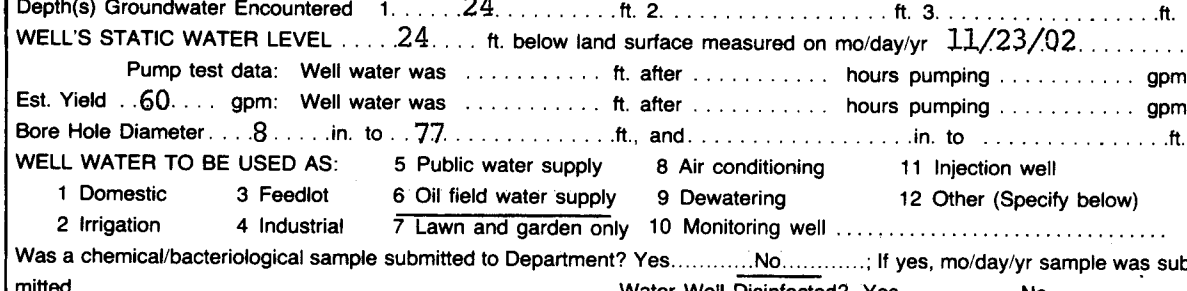

TYPE OF SCREEN OR PERFORATION MATERIAL:			7 PVC	10 Asbestos-cement
1 Steel	3 Stainless steel	5 Fiberglass	8 RMP (SR)	11 Other (specify)
2 Brass	4 Galvanized steel	6 Concrete tile	9 ABS	12 None used (open hole)

GRAVEL PACK INTERVALS:		From	ft. to	ft., From	ft. to	ft.
		20	77			
		From	ft. to	ft., From	ft. to	ft.

What is the nearest source of possible contamination:

1 Septic tank	4 Lateral lines	7 Pit privy	10 Livestock pens	14 Abandoned water well
2 Sewer lines	5 Cess pool	8 Sewage lagoon	11 Fuel storage	15 Oil well/Gas well
3 Watertight sewer lines	6 Seepage pit	9 Feedyard	12 Fertilizer storage	16 Other (specify below)
			13 Insecticide storage	

Direction from well?		East		How many feet?		120	
FROM	TO	LITHOLOGIC LOG		FROM	TO	PLUGGING INTERVALS	

[illegible]

7 CONTRACTOR'S OR LANDOWNER'S CERTIFICATION: This water well was (1) constructed, (2) reconstructed, or (3) plugged under my jurisdiction and was completed on (mo/day/year) 11/23/02 and this record is true to the best of my knowledge and belief. Kansas Water Well Contractor's License No. 186 This Water Well Record was completed on (mo/day/yr) 12/09/02 under the business name of Kelly's Water Well Service, Inc. by (signature) Rathum L. Doss

INSTRUCTIONS: Use typewriter or ball point pen. PLEASE PRESS FIRMLY and PRINT clearly. Please fill in blanks, underline or circle the correct answers. Send top three copies to Kansas Department of Health and Environment, Bureau of Water, Topeka, Kansas 66620-0001. Telephone: 913-296-5545. Send one to WATER WELL OWNER and retain one for your records.