

|         |                         |                |                |                 |              |
|---------|-------------------------|----------------|----------------|-----------------|--------------|
| 1       | LOCATION OF WATER WELL: | Fraction       | Section Number | Township Number | Range Number |
| County: | Stafford                | NW ¼ NE ¼ SW ¼ | 32             | T 21 S          | R 14w E/W    |


Distance and direction from nearest town or city street address of well if located within city?

downtown Radium, Ks.

|   |                                               |                           |                                                   |
|---|-----------------------------------------------|---------------------------|---------------------------------------------------|
| 2 | WATER WELL OWNER: Bill Spece                  | Sterling Drilling Company | Spece #1                                          |
|   | RR#, St. Address, Box # : 2224 Cleveland      | P. O. Box 1006            | Board of Agriculture, Division of Water Resources |
|   | City, State, ZIP Code : Great Bend, Ks. 67530 | Pratt, Ks. 67124          | Application Number:                               |

|   |                             |   |                         |    |     |            |         |
|---|-----------------------------|---|-------------------------|----|-----|------------|---------|
| 3 | LOCATE WELL'S LOCATION WITH | 4 | DEPTH OF COMPLETED WELL | 75 | ft. | ELEVATION: | unknown |
|---|-----------------------------|---|-------------------------|----|-----|------------|---------|

AN "X" IN SECTION BOX:

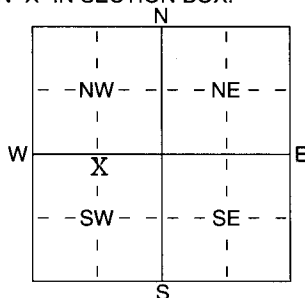

Depth(s) Groundwater Encountered 1 40 ft. 2 \_\_\_\_\_ ft. 3 \_\_\_\_\_ ft.  
WELL'S STATIC WATER LEVEL 40 ft. below land surface measured on mo/day/yr 02/25/04  
Pump test data: Well water was \_\_\_\_\_ ft. after \_\_\_\_\_ hours pumping \_\_\_\_\_ gpm  
Est. Yield 60 gpm: Well water was \_\_\_\_\_ ft. after \_\_\_\_\_ hours pumping \_\_\_\_\_ gpm  
WELL WATER TO BE USED AS:  
1 Domestic 3 Feedlot 5 Public water supply 8 Air conditioning 11 Injection well  
2 Irrigation 4 Industrial 7 Oil field water supply 9 Dewatering 12 Other (Specify below)  
6 Domestic (lawn & garden) 10 Monitoring well

Was a chemical/bacteriological sample submitted to Department? Yes ..... No .....; If yes, mo/day/yr sample was submitted

Water Well Disinfected? Yes \_\_\_\_\_ No \_\_\_\_\_

|   |                            |                |                 |                                          |
|---|----------------------------|----------------|-----------------|------------------------------------------|
| 5 | TYPE OF BLANK CASING USED: | 5 Wrought iron | 8 Concrete tile | CASING JOINTS: Glued ..... Clamped ..... |
|---|----------------------------|----------------|-----------------|------------------------------------------|

|         |            |                   |                         |                |
|---------|------------|-------------------|-------------------------|----------------|
| 1 Steel | 3 RMP (SR) | 6 Asbestos-Cement | 9 Other (specify below) | Welded .....   |
| 2 PVC   | 4 ABS      | 7 Fiberglass      |                         | Threaded ..... |

Blank casing diameter 5 in. to 55 ft., Dia        in. to        ft., Dia        in. to        ft.

Casing height above land surface 3 ft. below in., weight ..... lbs./ft. Wall thickness or gauge No. ....

TYPE OF SCREEN OR PERFORATION MATERIAL: 7 PVC 10 Asbestos-Cement

|         |                    |                 |            |                          |
|---------|--------------------|-----------------|------------|--------------------------|
| 1 Steel | 3 Stainless Steel  | 5 Fiberglass    | 8 RMP (SR) | 11 Other (Specify) ..... |
| 2 Brass | 4 Galvanized Steel | 6 Concrete tile | 9 ABS      | 12 None used (open hole) |

SCREEN OR PERFORATION OPENINGS ARE:                      5 Guazed wrapped                      8 Saw cut                      11 None (open hole)

|                    |               |                |                              |
|--------------------|---------------|----------------|------------------------------|
| 1 Continuous slot  | 3 Mill slot   | 6 Wire wrapped | 9 Drilled holes              |
| 2 Louvered shutter | 4 Kev punched | 7 Torch cut    | 10 Other (specify) _____ ft. |

SCREEN-PERFORATED INTERVALS: From 55 ft. to 75 ft. From \_\_\_\_\_ ft. to \_\_\_\_\_ ft.

GRAVEL PACK INTERVALS: From 30 ft. to 75 ft. From \_\_\_\_\_ ft. to \_\_\_\_\_ ft.

|   |                 |               |                |             |              |
|---|-----------------|---------------|----------------|-------------|--------------|
| 6 | GROUT MATERIAL: | 1 Neat cement | 2 Cement grout | 3 Bentonite | 4 Other..... |
|---|-----------------|---------------|----------------|-------------|--------------|

Grout Intervals: From 3 ft. to 23 ft. From 35 ft. to 40 ft. From \_\_\_\_\_ ft. to \_\_\_\_\_ ft.

What is the nearest source of possible contamination: 10 Livestock pens 14 Abandoned water well

|                          |                 |                 |                        |                          |
|--------------------------|-----------------|-----------------|------------------------|--------------------------|
| 1 Septic tank            | 4 Lateral lines | 7 Pit privy     | 11 Fuel storage        | 15 Oil well/Gas well     |
| 2 Sewer lines            | 5 Cess pool     | 8 Sewage lagoon | 12 Fertilizer storage  | 16 Other (specify below) |
| 3 Watertight sewer lines | 6 Seepage pit   | 9 Feedyard      | 13 Insecticide storage | .....                    |

Direction from well? \_\_\_\_\_ How many feet? \_\_\_\_\_

[illegible]

7 CONTRACTOR'S OR LANDOWNER'S CERTIFICATION: This water well was (1) constructed, (2) reconstructed, or (3) plugged under my jurisdiction and was completed on (mo/day/year) 02/25/04 and this record is true to the best of my knowledge and belief. Kansas Water Well Contractor's Licence No 186. This Water Well Record was completed on (mo/day/yr) 02/29/04 under the business name of Kelly's Water Well Service, Inc. by (signature) Kathleen L. Lynd