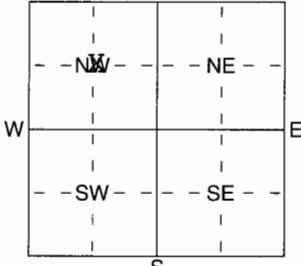


1 LOCATION OF WATER WELL: County: Stafford	Fraction $\frac{1}{4}$ NC $\frac{1}{4}$ NW $\frac{1}{4}$	Section Number 1	Township Number T 21 S	Range Number R 14w E/W
--	---	----------------------------	----------------------------------	----------------------------------

Distance and direction from nearest town or city street address of well if located within city?
1/2W, 5N of Seward, KS

2 WATER WELL OWNER: **Robert Rujan & Cheryl Rujan**
 RR#, St. Address, Box # : **5218 Quail Creek Drive**
 City, State, ZIP Code : **Great Bend, KS 67530**
 Board of Agriculture, Division of Water Resources
 Application Number: **31197**

3 LOCATE WELL'S LOCATION WITH AN "X" IN SECTION BOX: 	4 DEPTH OF COMPLETED WELL 95 ft. ELEVATION: unknown Depth(s) Groundwater Encountered 1 28 ft. 2 _____ ft. 3 _____ ft. WELL'S STATIC WATER LEVEL 28 ft. below land surface measured on mo/day/yr 04/27/05 Pump test data: Well water was _____ ft. after _____ hours pumping _____ gpm Est. Yield 1000 gpm: Well water was _____ ft. after _____ hours pumping _____ gpm WELL WATER TO BE USED AS: 1 Domestic 3 Feedlot 6 Oil field water supply 9 Dewatering 12 Other (Specify below) 2 Irrigation 4 Industrial 7 Domestic (lawn & garden) 10 Monitoring well _____ Was a chemical/bacteriological sample submitted to Department? Yes <u>No</u> ; If yes, mo/day/yrs sample was submitted Water Well Disinfected? Yes _____ No _____
--	--

5 TYPE OF BLANK CASING USED:
 1 Steel 3 RMP (SR) 5 Wrought iron 8 Concrete tile CASING JOINTS: Glued _____ Clamped _____
 2 PVC 4 ABS 6 Asbestos-Cement 9 Other (specify below) Welded
 7 Fiberglass _____ Threaded _____
 Blank casing diameter **1.6** in. to **6.5** ft., Dia _____ in. to _____ ft., Dia _____ in. to _____ ft.
 Casing height above land surface **1.2** in., weight **16.5** lbs./ft. Wall thickness or gauge No. **Sch. 40**
 TYPE OF SCREEN OR PERFORATION MATERIAL:
 1 Steel 3 Stainless Steel 5 Fiberglass 7 PVC 10 Asbestos-Cement
 2 Brass 4 Galvanized Steel 6 Concrete tile 8 RMP (SR) 11 Other (Specify) _____
 9 ABS 12 None used (open hole)
 SCREEN OR PERFORATION OPENINGS ARE:
 1 Continuous slot 3 Mill slot 5 Gauzed wrapped 8 Saw cut 11 None (open hole)
 2 Louvered shutter 4 Key punched 6 Wire wrapped 9 Drilled holes
 7 Torch cut 10 Other (specify) _____ ft.
 SCREEN-PERFORATED INTERVALS: From **65** ft. to **95** ft., From _____ ft. to _____ ft.
 From _____ ft. to _____ ft., From _____ ft. to _____ ft.
 GRAVEL PACK INTERVALS: From **20** ft. to **95** ft., From _____ ft. to _____ ft.
 From _____ ft. to _____ ft., From _____ ft. to _____ ft.

6 GROUT MATERIAL: 1 Neat cement 2 Cement grout 3 Bentonite 4 Other _____
 Grout Intervals: From **0** ft. to **18 (2)** ft., From **18** ft. to **20 (3)** ft., From _____ ft. to _____ ft.
 What is the nearest source of possible contamination:
 1 Septic tank 4 Lateral lines 7 Pit privy 10 Livestock pens 14 Abandoned water well
 2 Sewer lines 5 Cess pool 8 Sewage lagoon 11 Fuel storage 15 Oil well/Gas well
 3 Watertight sewer lines 6 Seepage pit 9 Feedyard 12 Fertilizer storage 16 Other (specify below)
 13 Insecticide storage **none - in field**
 Direction from well? _____ How many feet? _____

FROM	TO	LITHOLOGIC LOG	FROM	TO	PLUGGING INTERVALS
0	3	top sand and soil			
3	15	clay			
15	76	sand and gravel			
76	81	clay			
81	94	sand and gravel			
94	95	clay			

7 CONTRACTOR'S OR LANDOWNER'S CERTIFICATION: This water well was (1) constructed, (2) reconstructed, or (3) plugged under my jurisdiction and was completed on (mo/day/year) **04/27/05** and this record is true to the best of my knowledge and belief. Kansas Water Well Contractor's Licence No **186**. This Water Well Record was completed on (mo/day/yr) **05/05/05** under the business name of **Kelly's Water Well Service, Inc.** by (signature) *Kathryn L. Brad*

INSTRUCTIONS: Use typewriter or ball point pen. PLEASE PRESS FIRMLY and PRINT clearly. Please fill in blanks, underline or circle the correct answers. Send top three copies to Kansas Department of Health and Environment, Bureau of Water, Geology Section, 1000 SW Jackson St., Suite 420, Topeka, Kansas 66612-1367. Telephone 785-296-5522. Send one to WATER WELL OWNER and retain one for your records. Fee of \$5.00 for each constructed well.