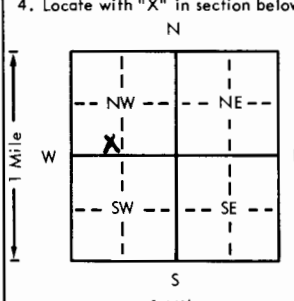


USE TYPEWRITER OR BALL POINT PEN-PRESS FIRMLY, PRINT CLEARLY.

WATER WELL RECORD
KSA 82a-1201-1215

Kansas Department of Health and Environment-Division of Environment
(Water well Contractors)
Topeka, Kansas 66620

1. Location of well:	County Stafford	Fraction SE 1/4 SW 1/4 NW 4	Section number 2	Township number T 21	Range number S 14 10
2. Distance and direction from nearest town or city: Street address of well location if in city:			3. Owner of well: R.R. or street: City, state, zip code:		
6 S. 4 W. Great Bend, KS			WOODMAN - JANNITI DR 19, CO. Box 308 Great Bend, KS		
4. Locate with "X" in section below: Sketch map: 			6. Bore hole dia. <u>6</u> in. Completion date <u>7-29-77</u> Well depth <u>50</u> ft.		
5. Type and color of material			7. <input type="checkbox"/> Cable tool <input checked="" type="checkbox"/> Rotary <input type="checkbox"/> Driven <input type="checkbox"/> Dug <input type="checkbox"/> Hollow rod <input type="checkbox"/> Jetted <input type="checkbox"/> Bored <input type="checkbox"/> Reverse rotary		
			8. Use: <input type="checkbox"/> Domestic <input type="checkbox"/> Public supply <input type="checkbox"/> Industry <input type="checkbox"/> Irrigation <input type="checkbox"/> Air conditioning <input type="checkbox"/> Stock <input type="checkbox"/> Lawn <input checked="" type="checkbox"/> Oil field water <input type="checkbox"/> Other		
			9. Casing: Material _____ Height: Above ground _____ Threaded _____ Welded _____ Surface <u>12</u> in. RMP _____ PVC <input checked="" type="checkbox"/> Weight _____ lbs./ft. Dia. <u>2</u> in. to <u>50</u> ft. depth Wall Thickness: inches or _____ Dia. _____ in. to _____ ft. depth gage No. <u>sch 40</u>		
			10. Screen: Manufacturer's name _____ <u>MPI</u> Type <u>PVC</u> Dia. <u>2"</u> Slot/gauze <u>1/16"</u> Length <u>20'</u> Set between <u>30</u> ft. and <u>50</u> ft. _____ ft. and _____ ft. Gravel pack? <input checked="" type="checkbox"/> Size range of material <u>1/4-3/4"</u>		
			11. Static water level: _____ mo./day/yr. <u>8</u> ft. below land surface Date <u>7-29-77</u>		
			12. Pumping level below land surfaces: _____ ft. after _____ hrs. pumping _____ g.p.m. _____ ft. after _____ hrs. pumping _____ g.p.m. Estimated maximum yield <u>50</u> g.p.m.		
			13. Water sample submitted: _____ mo./day/yr. Yes <input checked="" type="checkbox"/> No <input type="checkbox"/> Date _____		
			14. Well head completion: <input type="checkbox"/> Pitless adapter _____ Inches above grade		
			15. Well grouted? <input checked="" type="checkbox"/> With: <input type="checkbox"/> Neat cement <input checked="" type="checkbox"/> Bentonite <input type="checkbox"/> Concrete Depth: From <u>0</u> ft. to <u>10</u> ft.		
			16. Nearest source of possible contamination: <u>oil</u> ft. <u>65</u> Direction <u>S</u> Type <u>Test</u> Well disinfected upon completion? Yes <input type="checkbox"/> No <input checked="" type="checkbox"/>		
			17. Pump: <input checked="" type="checkbox"/> Not installed Manufacturer's name _____ Model number _____ HP _____ Volts _____ Length of drop pipe _____ ft. capacity _____ g.p.m. Type: <input type="checkbox"/> Submersible <input type="checkbox"/> Turbine <input type="checkbox"/> Jet <input type="checkbox"/> Reciprocating <input type="checkbox"/> Centrifugal <input type="checkbox"/> Other		
(Use a second sheet if needed)					
18. Elevation:		19. Remarks:		20. Water well contractor's certification: This well was drilled under my jurisdiction and this report is true to the best of my knowledge and belief. <u>186</u> <u>Kelly's Water Well Service</u> Business name _____ License No. _____ Address <u>R. 2 Great Bend, KS</u> Signed <u>Kelly Price</u> Date <u>8-11-77</u> Authorized representative	
Topography: <input type="checkbox"/> Hill <input type="checkbox"/> Slope <input checked="" type="checkbox"/> Upland <input type="checkbox"/> Valley					

T 21
R 14
E 10
Sec 2
SE 1/4 SW 1/4 NW 4

Forward the white, blue and pink copies to the Department of Health and Environment

Form WWC-5