


1 LOCATION OF WATER WELL: Fraction NW 1/4 NE 1/4 SE 1/4 Section Number 7 Township Number T 21 S Range Number R 14W E/W
 County: Stafford

Distance and direction from nearest town or city street address of well if located within city?
 1/2 N of Radium, Kansas

2 WATER WELL OWNER: Lobo Drilling
 RR#, St. Address, Box #: Box 823
 City, State, ZIP Code: Great Bend, Kansas 67530
 Board of Agriculture, Division of Water Resources
 Application Number: Unknown

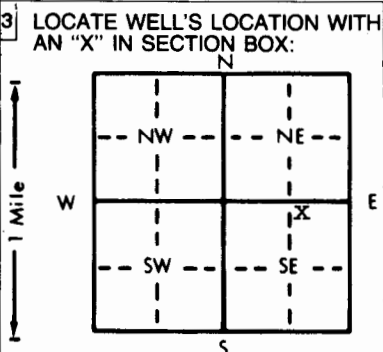

4 DEPTH OF COMPLETED WELL: 62 ft. ELEVATION: Unknown
 Depth(s) Groundwater Encountered 1. 18 ft. 2. ft. 3. ft.
 WELL'S STATIC WATER LEVEL: 18 ft. below land surface measured on mo/day/yr 11/11/81
 Pump test data: Well water was ft. after hours pumping gpm
 Est. Yield 60 gpm: Well water was ft. after hours pumping gpm
 Bore Hole Diameter: 8 in. to 62 ft., and in. to ft.
 WELL WATER TO BE USED AS:
 1 Domestic 3 Feedlot 6 Oil field water supply 9 Dewatering 12 Other (Specify below)
 2 Irrigation 4 Industrial 7 Lawn and garden only 10 Observation well
 Was a chemical/bacteriological sample submitted to Department? Yes, No; If yes, mo/day/yr sample was submitted
 Water Well Disinfected? Yes, No

5 TYPE OF BLANK CASING USED:
 1 Steel 3 RMP (SR) 5 Wrought iron 8 Concrete tile CASING JOINTS: Glued, Clamped, Welded, Threaded
 2 PVC 4 ABS 6 Asbestos-Cement 9 Other (specify below)
 7 Fiberglass
 Blank casing diameter 5 in. to 42 ft., Dia. in. to ft., Dia. in. to ft.
 Casing height above land surface 12 in., weight 2.8 lbs./ft. Wall thickness or gauge No. Sch. 40
 TYPE OF SCREEN OR PERFORATION MATERIAL:
 1 Steel 3 Stainless steel 5 Fiberglass 7 PVC 8 RMP (SR) 10 Asbestos-cement 11 Other (specify)
 2 Brass 4 Galvanized steel 6 Concrete tile 9 ABS 12 None used (open hole)
 SCREEN OR PERFORATION OPENINGS ARE:
 1 Continuous slot 3 Mill slot 5 Gauzed wrapped 8 Saw cut 11 None (open hole)
 2 Louvered shutter 4 Key punched 6 Wire wrapped 9 Drilled holes
 7 Torch cut 10 Other (specify)
 SCREEN-PERFORATED INTERVALS: From 42 ft. to 62 ft., From ft. to ft.
 GRAVEL PACK INTERVALS: From 10 ft. to 62 ft., From ft. to ft.

6 GROUT MATERIAL: 1 Neat cement 2 Cement grout 3 Bentonite 4 Other
 Grout Intervals: From 0 ft. to 10 ft., From ft. to ft., From ft. to ft.
 What is the nearest source of possible contamination:
 1 Septic tank 4 Lateral lines 7 Pit privy 10 Livestock pens 14 Abandoned water well
 2 Sewer lines 5 Cess pool 8 Sewage lagoon 11 Fuel storage 15 Oil well/Gas well
 3 Watertight sewer lines 6 Seepage pit 9 Feedyard 12 Fertilizer storage 16 Other (specify below)
 13 Insecticide storage
 Direction from well? East How many feet? 60

FROM	TO	LITHOLOGIC LOG	FROM	TO	LITHOLOGIC LOG
0	25	Clay			
25	62	Sand and Gravel			

7 CONTRACTOR'S OR LANDOWNER'S CERTIFICATION: This water well was (1) constructed, (2) reconstructed, or (3) plugged under my jurisdiction and was completed on (mo/day/year) 11/11/81 and this record is true to the best of my knowledge and belief. Kansas Water Well Contractor's License No. 186 This Water Well Record was completed on (mo/day/yr) 12/31/81 under the business name of Kellys Water Well Service by (signature)

INSTRUCTIONS: Use typewriter or ball point pen, PLEASE PRESS FIRMLY and PRINT clearly. Please fill in blanks, underline or circle the correct answers. Send top three copies to Kansas Department of Health and Environment, Division of Environment, Environmental Geology Section, Topeka, KS 66620. Send one to WATER WELL OWNER and retain one for your records.

OFFICE USE ONLY
121
14
17
SEC 7
NW 1/4
NE 1/4
SE 1/4