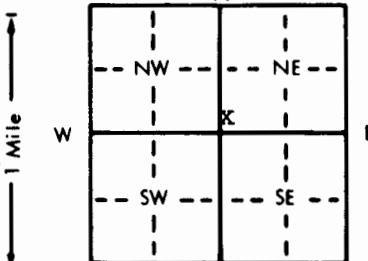


1 LOCATION OF WATER WELL:		Fraction	Section Number	Township Number	Range Number
County: <u>Stafford</u>		<u>SW</u> $\frac{1}{4}$ <u>SW</u> $\frac{1}{4}$ <u>NE</u> $\frac{1}{4}$	<u>17</u>	<u>T</u> <u>21</u> <u>S</u>	<u>R</u> <u>14W</u> <u>EW</u>
Distance and direction from nearest town or city street address of well if located within city? <u>4 N, $\frac{1}{2}$ E of Radium, Kansas</u>					
2 WATER WELL OWNER:		<u>Woodman & Iannitti Oil Company</u>			
RR#, St. Address, Box # :		<u>1008 Douglas Bldg., 104 S. Broadway</u>		Board of Agriculture, Division of Water Resources	
City, State, ZIP Code :		<u>Wichita, Kansas 67202</u>		Application Number: <u>Unknown</u>	
3 LOCATE WELL'S LOCATION WITH AN "X" IN SECTION BOX:		4 DEPTH OF COMPLETED WELL: <u>79</u> ft. ELEVATION: <u>Unknown</u>			
		Depth(s) Groundwater Encountered 1. <u>26</u> ft. 2. <u>35</u> ft. 3. _____ ft.			
		WELL'S STATIC WATER LEVEL _____ ft. below land surface measured on mo/day/yr <u>8/7/81</u>			
		Pump test data: Well water was _____ ft. after _____ hours pumping _____ gpm			
		Est. Yield <u>60</u> gpm: Well water was _____ ft. after _____ hours pumping _____ gpm			
Bore Hole Diameter: <u>8</u> in. to <u>79</u> ft., and _____ in. to _____ ft.		WELL WATER TO BE USED AS:			
1 Domestic		3 Feedlot	6 <u>Oil field water supply</u>	9 Dewatering	12 Other (Specify below)
2 Irrigation		4 Industrial	7 Lawn and garden only	10 Observation well	
Was a chemical/bacteriological sample submitted to Department? Yes _____ No _____; If yes, mo/day/yr sample was submitted _____					
Water Well Disinfected? Yes _____ No _____					
5 TYPE OF BLANK CASING USED:					
1 Steel		3 RMP (SR)	5 Wrought iron	8 Concrete tile	CASING JOINTS: <u>Glued</u> _____ Clamped _____
2 <u>PVC</u>		4 ABS	6 Asbestos-Cement	9 Other (specify below)	Welded _____
Blank casing diameter _____ in. to _____ in.		7 Fiberglass			Threaded _____
Casing height above land surface _____ in., weight _____ lbs./ft.					Wall thickness or gauge No. <u>Sch. 40</u>
TYPE OF SCREEN OR PERFORATION MATERIAL:					
1 Steel		3 Stainless steel	5 Fiberglass	7 <u>PVC</u>	10 Asbestos-cement
2 Brass		4 Galvanized steel	6 Concrete tile	8 RMP (SR)	11 Other (specify) _____
SCREEN OR PERFORATION OPENINGS ARE:				9 ABS	12 None used (open hole)
1 Continuous slot		3 Mill slot	5 Gauzed wrapped	8 <u>Saw cut</u>	11 None (open hole)
2 Louvered shutter		4 Key punched	6 Wire wrapped	9 Drilled holes	
SCREEN-PERFORATED INTERVALS: From _____ ft. to _____ ft.				10 Other (specify) _____	
GRAVEL PACK INTERVALS: From _____ ft. to _____ ft.					
6 GROUT MATERIAL:					
1 <u>Neat cement</u>		2 Cement grout	3 Bentonite	4 Other _____	
Grout Intervals: From _____ ft. to _____ ft.					
What is the nearest source of possible contamination:					
1 Septic tank		4 Lateral lines	7 Pit privy	10 Livestock pens	14 Abandoned water well
2 Sewer lines		5 Cess pool	8 Sewage lagoon	11 Fuel storage	15 <u>Oil well/Gas well</u>
3 Watertight sewer lines		6 Seepage pit	9 Feedyard	12 Fertilizer storage	16 Other (specify below)
13 Insecticide storage					
Direction from well? <u>East</u> How many feet? <u>60</u>					
FROM		TO	LITHOLOGIC LOG		
0		35	Clay		
35		79	Sand and Gravel		
7 CONTRACTOR'S OR LANDOWNER'S CERTIFICATION: This water well was (1) <u>constructed</u> , (2) reconstructed, or (3) plugged under my jurisdiction and was completed on (mo/day/year) <u>8/7/81</u> and this record is true to the best of my knowledge and belief. Kansas Water Well Contractor's License No. <u>186</u> . This Water Well Record was completed on (mo/day/yr) <u>9/15/81</u> under the business name of <u>Kellys WaterWells</u> by (signature) <u>Kelly Price</u>					
INSTRUCTIONS: Use typewriter or ball point pen, PLEASE PRESS FIRMLY and PRINT clearly. Please fill in blanks, underline or circle the correct answers. Send top three copies to Kansas Department of Health and Environment, Division of Environment, Environmental Geology Section, Topeka, KS 66620. Send one to WATER WELL OWNER and retain one for your records.					