

WATER WELL RECORD

Form WWC-5


Division of Water Resources App. No.

20150261

1 LOCATION OF WATER WELL: County: Stafford Fraction 1/4 SE 1/4 NE 1/4 SW 1/4 Section Number 20 Township No. T 21 S Range Number R 14 [ ] E [ ] W

Street/Rural Address of Well Location; if unknown, distance & direction from nearest town or intersection: If at owner's address, check here [ ] 2 1/4 North, 1/4 East of Radium Global Positioning System (GPS) information: Latitude: 38.20780 Longitude: 098.88562 Elevation: Datum: [ ] WGS 84, [ ] NAD 83, [ ] NAD 27 Collection Method: [ ] GPS unit, [ ] Digital Map/Photo, [ ] Topographic Map, [ ] Land Survey Est. Accuracy: [ ] <3 m, [ ] 3-5 m, [ ] 5-15 m, [ ] >15 m

2 WATER WELL OWNER: Carmen Schmitt Inc. RR#, Street Address, Box #: PO Box 47 City, State, ZIP Code : Great Bend, KS 67530

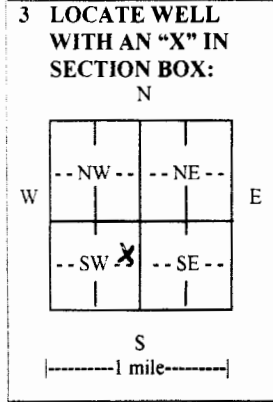

4 DEPTH OF COMPLETED WELL 100 ft. Depth(s) Groundwater Encountered (1)..... ft. (2)..... ft. (3)..... ft. WELL'S STATIC WATER LEVEL 34 ft. below land surface measured on mo/day/yr. 7-13-15 Pump test data: Well water was..... ft. after..... hours pumping..... gpm EST. YIELD N/A gpm. Well water was..... ft. after..... hours pumping..... gpm Bore Hole Diameter 10 in. to 100 ft., and..... in. to..... ft. WELL WATER TO BE USED AS: [ ] Public water supply [ ] Geothermal [ ] Injection well [ ] Domestic [ ] Feedlot [ ] Oil field water supply [ ] Dewatering [ ] Other (Specify below) [ ] Irrigation [ ] Industrial [ ] Domestic-lawn & garden [ ] Monitoring well Was a chemical/bacteriological sample submitted to Department? [ ] Yes [ ] No If yes, mo/day/yr sample was submitted..... Water well disinfected? [ ] Yes [ ] No

5 TYPE OF CASING USED: [ ] Steel [ ] PVC [ ] Other CASING JOINTS: [ ] Glued [ ] Clamped [ ] Welded [ ] Threaded Casing diameter 5 in. to 100 ft., Diameter..... in. to..... ft., Diameter..... in. to..... ft. Casing height above land surface 18 in., Weight SDR-26 lbs./ft., Wall thickness or gauge No. TYPE OF SCREEN OR PERFORATION MATERIAL: [ ] Steel [ ] Stainless Steel [ ] PVC [ ] Other (Specify) [ ] Brass [ ] Galvanized Steel [ ] None used (open hole) SCREEN OR PERFORATION OPENINGS ARE: [ ] Continuous slot [ ] Mill slot [ ] Gauze wrapped [ ] Torch cut [ ] Drilled holes [ ] None (open hole) [ ] Louvered shutter [ ] Key punched [ ] Wire wrapped [ ] Saw cut [ ] Other (specify) SCREEN-PERFORATED INTERVALS: From 100 ft. to 80 ft., From..... ft. to..... ft. From..... ft. to..... ft., From..... ft. to..... ft. GRAVEL PACK INTERVALS: From 100 ft. to 20 ft., From..... ft. to..... ft. From..... ft. to..... ft., From..... ft. to..... ft.

6 GROUT MATERIAL: [ ] Neat cement [ ] Cement grout [ ] Bentonite [ ] Other Grout Intervals: From..... ft. to..... ft., From 20 ft. to 0 ft., From..... ft. to..... ft. What is the nearest source of possible contamination: [ ] Septic tank [ ] Lateral lines [ ] Pit privy [ ] Livestock pens [ ] Insecticide storage [ ] Other (specify below) [ ] Sewer lines [ ] Cesspool [ ] Sewage lagoon [ ] Fuel storage [ ] Abandoned water well [ ] Watertight sewer lines [ ] Seepage pit [ ] Feedyard [ ] Fertilizer storage [ ] Oil well/gas well None Direction from well..... Distance from well.....

Table with columns: FROM, TO, LITHOLOGIC LOG, FROM, TO, LITHO. LOG (cont.) or PLUGGING INTERVALS. Rows: 0-3 Sandy top soil, 3-16 Gray clay, 16-35 Sand, 35-69 Sand & gravel- small to med, 69-74 Tan clay, 74-100 Sand & gravel- small to med.

7 CONTRACTOR'S OR LANDOWNER'S CERTIFICATION: This water well was [ ] constructed, [ ] reconstructed, or [ ] plugged under my jurisdiction and was completed on (mo/day/year) 7-13-15 and this record is true to the best of my knowledge and belief. Kansas Water Well Contractor's License No. 134 This Water Well Record was completed on (mo/day/year) 7-17-15 under the business name of Rosecrantz-Bemis Ent Inc by (signature) [Signature]

INSTRUCTIONS: Use typewriter or ball point pen. PLEASE PRESS FIRMLY and PRINT clearly. Please fill in blanks and check the correct answers. Send one copy to Kansas Department of Health and Environment, Bureau of Water, Geology Section, 1000 SW Jackson St., Suite 420, Topeka, Kansas 66612-1367. Telephone 785-296-5524. Send one copy to WATER WELL OWNER and retain one for your records. Include fee of \$5.00 for each constructed well. Visit us at



ASSIGNMENT OF WATER WELL TO LANDOWNER

I, Carmen Schmitt of P.O. Box 47 - Great Bend, KS  
(Landowner's address)

67530 am the landowner on which a water well is located in  
(City) (State)  
the SE quarter of the NE quarter of the SW quarter in Section 20, Township 21S,  
Range 14 E(W) in Stafford County, Kansas which is approximately  
1594 feet north/south, and 2620' feet east/west of the apparent SW section  
corner. The water well was drilled in July 2015 (month/year).

I hereby request that Carmen Schmitt Inc. leave the water well,  
(Operator name)

which was drilled by Temporary Water Permit # 20150261, unplugged, and I will  
assume all responsibility for the plugging of said water well in accordance with the requirements  
of the Kansas Department of Health and Environment regulation K.A.R. 28-30-7.

LANDOWNER:

Carmen Schmitt 7/30/15  
(Signature) (Date)

Carmen Schmitt  
(Print)

OPERATOR:

Matt Suchy 7/30/15  
(Signature) Production Manager (Date)

By: \_\_\_\_\_  
(Agent)

IF ADDITIONAL LANDOWNER

\_\_\_\_\_  
(Signature) (Date)

\_\_\_\_\_  
(Print)

**COPY**

RECEIVED  
AUG 03 2015  
BUREAU OF WATER