USE TYPEWRITER OR BALL POINT PEN-PRESS FIRMLY, PRINT CLEARLY.

WATER WELL RECORD
KSA 82a-1201-1215

Kansas Department of Health and Environment-Division of Environment
(Water well Contractors)
Topeka, Kansas 66620

1. Location of well:	County	Fraction	Section number	Township number	Range number
	Stafford	Center of 1/4 1/4 SE 1/4	23	T 21 S	R 14 E/W

2. Distance and direction from nearest town or city:
3½ miles Northwest of Seward, KS
Street address of well location if in city:

3. Owner of well: Harold Titus
R.R. or street: Box 1010
City, state, zip code: Great Bend, KS 67530

4. Locate with "X" in section below:

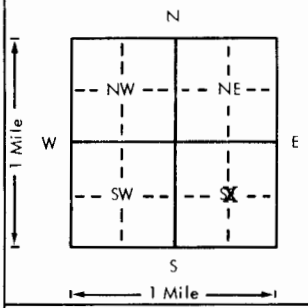

Sketch map:

6. Bore hole dia. 24 in. Completion date 12-2-77
Well depth 97 ft. Pump Set 5-17-78

7. __ Cable tool __ Rotary __ Driven __ Dug
__ Hollow rod __ Jetted __ Bored X Reverse rotary

8. Use: __ Domestic __ Public supply __ Industry
X Irrigation __ Air conditioning __ Stock
__ Lawn __ Oil field water __ Other

9. Casing: Material steel Height: Above or below
Threaded ___ Welded X Surface 12 in.
RMP ___ PVC ___ Weight 30.3 lbs./ft.
Dia. 16 in. to 57 ft. depth Wall Thickness: inches or
Dia. ___ in. to ___ ft. depth gage No. 7 ga.

10. Screen: Manufacturer's name W. A. Brown
Type Double-slot Dia. 16"
Slot/gauze 1/8" Length 40'
Set between 57 ft. and 97 ft.
___ ft. and ___ ft.
Gravel pack? Yes Size range of material 3/8-200

11. Static water level: mo./day/yr.
17'6" ft. below land surface Date 12-2-77

12. Pumping level below land surfaces: Not Checked
___ ft. after ___ hrs. pumping ___ g.p.m.
___ ft. after ___ hrs. pumping ___ g.p.m.
Estimated maximum yield ___ g.p.m.

13. Water sample submitted: mo./day/yr.
__ Yes X No Date ___

14. Well head completion:
__ Pitless adapter 12 Inches above grade

15. Well grouted? Yes
With: X Neat cement ___ Bentonite ___ Concrete
Depth: From 0 ft. to 10 ft.

16. Nearest source of possible contamination: Field
ft. ___ Direction ___ Type ___
Well disinfected upon completion? ___ Yes X No

17. Pump: __ Not installed
Manufacturer's name Peerless Pump Co.
Model number 12MB-4 HP 75 Volts 460
Length of drop pipe 70 ft. capacity 1000 g.p.m.
Type:
__ Submersible X Turbine
__ Jet __ Reciprocating
__ Centrifugal __ Other

5. Type and color of material	From	To
Top soil and sand	0	5
Sandy clay	5	21
Sand	21	27
Sandy clay & sand	27	36
Sand & gravel	36	52
Brown & gray clay	52	56
Sand & gravel	56	75
Brown clay	75	77
Sand and gravel	77	84
Gray clay	84	87
Sand and gravel	87	96
Gray clay	96	97
(Use a second sheet if needed)		

18. Elevation:

Topography:
__ Hill
__ Slope
__ Upland
__ Valley

19. Remarks:

20. Water well contractor's certification:
This well was drilled under my jurisdiction and this report is true to the best of my knowledge and belief.
Clarke Well & Eq., Inc. 185
Business name License No.
Address Great Bend, KS 67530
Signed [signature] Date 5-18-78
Authorized representative

21 T 14 R E 23 Sec 1 1/4 1/4 1/4 CSE

Forward the white, blue and pink copies to the Department of Health and Environment

Form WWC-5

MI-1023