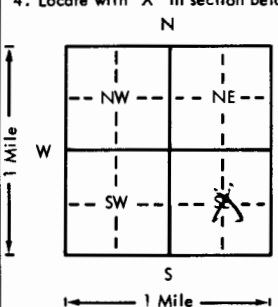


USE TYPEWRITER OR BALL POINT PEN—PRESS FIRMLY, PRINT CLEARLY.

WATER WELL RECORD
KSA 82a-1201-1215

Kansas Department of Health and Environment—Division of Environment
(Water well Contractors)
Topeka, Kansas 66620

1. Location of well:	County Stafford	Fraction 1/4 1/4 CSE 1/4	Section number 24	Township number T 21 S R 14 E (M)	Range number
2. Distance and direction from nearest town or city: Street address of well location if in city:	2 N Seward, KS		3. Owner of well: R.R. or street: City, state, zip code: Robert Mullen R 2 Great Bend, KS		
4. Locate with "X" in section below:	Sketch map: 		6. Bore hole dia. 30 in. Completion date 12-12-75 Well depth 98 ft.		
5. Type and color of material	From	To	7. <input type="checkbox"/> Cable tool <input type="checkbox"/> Rotary <input type="checkbox"/> Driven <input type="checkbox"/> Dug <input type="checkbox"/> Hollow rod <input type="checkbox"/> Jetted <input type="checkbox"/> Bored <input checked="" type="checkbox"/> Reverse rotary		
Top Soil - Clay	0	40	8. Use: <input type="checkbox"/> Domestic <input type="checkbox"/> Public supply <input type="checkbox"/> Industry <input checked="" type="checkbox"/> Irrigation <input type="checkbox"/> Air conditioning <input type="checkbox"/> Stock <input type="checkbox"/> Lawn <input type="checkbox"/> Oil field water <input type="checkbox"/> Other		
Sand - Gravel	40	75	9. Casing: Material Iron Height: Above or below Threaded <input type="checkbox"/> Welded <input checked="" type="checkbox"/> Surface 24 in. RMP <input type="checkbox"/> PVC <input type="checkbox"/> Weight <input type="checkbox"/> lbs./ft.		
Clay	75	77	Dia. 16 in. to 98 ft. depth Wall Thickness: inches or Dia. <input type="checkbox"/> in. to <input type="checkbox"/> ft. depth gage No. 79a		
Sand - Gravel	77	102	10. Screen: Manufacturer's name DOERR Type IRON Dia. 16" Slot/gauze 1/8" Length 30 Set between 68 ft. and 98 ft. <input type="checkbox"/> ft. and <input type="checkbox"/> ft. Gravel pack? <input checked="" type="checkbox"/> Size range of material 44-3/4"		
			11. Static water level: <input type="checkbox"/> mo./day/yr. 11 ft. below land surface Date 12-12-75		
			12. Pumping level below land surfaces: 39 ft. after 4 hrs. pumping 1300 g.p.m. <input type="checkbox"/> ft. after <input type="checkbox"/> hrs. pumping <input type="checkbox"/> g.p.m. Estimated maximum yield 1600 g.p.m.		
			13. Water sample submitted: <input type="checkbox"/> Yes <input checked="" type="checkbox"/> No Date <input type="checkbox"/>		
			14. Well head completion: <input type="checkbox"/> Pitless adapter 24 Inches above grade		
			15. Well grouted? <input checked="" type="checkbox"/> With: <input type="checkbox"/> Neat cement <input type="checkbox"/> Bentonite <input checked="" type="checkbox"/> Concrete Depth: From 0 ft. to 10 ft.		
			16. Nearest source of possible contamination: NONE ft. <input type="checkbox"/> Direction <input type="checkbox"/> Type <input type="checkbox"/> Well disinfected upon completion? <input type="checkbox"/> Yes <input type="checkbox"/> No		
			17. Pump: <input type="checkbox"/> Not installed Manufacturer's name Goulds Model number 4-12-Tic HP 50 Volts 460 Length of drop pipe 65 ft. capacity 900 g.p.m. Type: <input type="checkbox"/> Submersible <input checked="" type="checkbox"/> Turbine <input type="checkbox"/> Jet <input type="checkbox"/> Reciprocating <input type="checkbox"/> Centrifugal <input type="checkbox"/> Other		
18. Elevation:	19. Remarks:		20. Water well contractor's certification: This well was drilled under my jurisdiction and this report is true to the best of my knowledge and belief. Kelly's Water Well Service Business name License No. Address R 2 Great Bend, KS Signed Billy Price Date 12-2-75 Authorized representative		

Forward the white, blue and pink copies to the Department of Health and Environment

Form WWC-5