USE TYPEWRITER OR BALL POINT PEN-PRESS FIRMLY, PRINT CLEARLY.

T R EW sec 1/4 1/4 1/4 No.

WATER WELL RECORD
KSA 82a-1201-1215

Kansas State Dept. Of Health
(Water Well Contractors)
Forbes-Bldg. 740
Topeka, Kansas 66620

1 Location of well:	County	Township name	Fraction	Section number	Town number	Range number
	Stafford	Lincoln	SW of NE	33	T21S	R14W

Distance and direction from nearest town or city: 4 mi. West of Seward, Kansas
Street address of well location if in city:

3 Owner of well: H. A. Chapman Investments
Address: Great Bend, Kansas

Locate with "X" in section below:

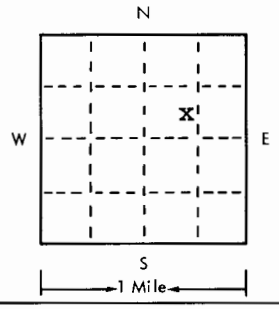

Sketch map:

4 Well depth: 63 ft. Date of completion 6-9-75
Well diameter 9 in.

5 ☐ Cable tool ☒ Rotary ☐ Driven ☐ Dug ☐ Hollow rod ☐ Jetted ☐ Bored ☐ Reverse rotary

6 Use: ☒ Domestic ☐ Public supply ☐ Industry ☐ Irrigation ☐ Air conditioning ☐ Commercial ☐ Test well ☐ _____

7 Casing: Material Styrene Weight: (above) below
Threaded ☐ Welded ☒ Surface 12 in.
Diam. 5 in. to 48 ft. depth Weight 1.5 lbs./ft.
Drive shoe? ☐ Yes ☒ No
___ in. to ___ ft. depth

2 Type and color of material	From	To
Sandy top soil	0	2
Gray & brown clay	2	21
Sand & gravel	21	63
(use a second sheet if needed)		

8 Screen:
Manufacturer Jess & Lowell
Type Styrene 200 Dia. 5"
(Slot) gauze 1/8 Length 15'
Set between 48 ft. and 63 ft.
Fittings:
Gravel pack ☒ Yes ☐ No Size range of material 3/8--200

9 Static water level:
12 ft. below land surface Date 6-9-75

10 Pumping level below land surfaces: N/C
___ ft. after ___ hrs. pumping ___ g.p.m.
___ ft. after ___ hrs. pumping ___ g.p.m.
Estimated maximum yield ___ g.p.m.

11 Water sample submitted:
☐ Yes ☒ No Date ___

12 Well head completion:
☐ Pitless adapter 12 Inches above grade

13 Well grouted? ☒ Yes ☐ No
☒ Neat cement ☐ Bentonite ☐ _____
Depth: From 0 ft. to 10 ft.

14 Nearest source of possible contamination: NONE KNOWN
ft. ___ Direction ___ Type ___
Well disinfected upon completion? ☐ Yes ☒ No

15 Pump: ☒ Not installed
Manufacturer's name ___
Model number ___ HP ___ Volts ___
Length of drop pipe ___ ft. capacity ___ g.m.p.
Type:
☐ Submersible ☐ Turbine
☐ Jet ☐ Reciprocating
☐ Certrifugal ☐ Other

16 Remarks: elevation

Topography:
☐ Hill
☐ Slope
☐ Upland
☐ Valley

17 Water well contractor's certification:
This well was drilled under my jurisdiction and this report is true to the best of my knowledge and belief.
Clarke Well & Eq., Inc. 185
Business name License No.
Address Great Bend, KS
Signed R. W. Clarke 6-9-75
Authorized representative

Forward the white, blue and pink copies to the Kansas State Dept. Of Health.

Form WWC-5

677-H