USE TYPEWRITER OR BALL POINT PEN-PRESS FIRMLY, PRINT CLEARLY.

T R EW sec 1/4 1/4 1/4 No.

WATER WELL RECORD
KSA 82a-1201-1215

Kansas State Dept. Of Health
(Water Well Contractors)
Forbes-Bldg. 740
Topeka, Kansas 66620

1 Location of well: County: Stafford	Township name	Fraction: NW-SW-NE	Section number: 33	Town number: 21 S	Range number: 14 W

Distance and direction from nearest town or city: 2-east ½ north of Radium

Street address of well location if in city:

3 Owner of well: Duke Drilling Co Great Bend Ks. Example #4

Address:

Locate with "X" in section below: Sketch map:

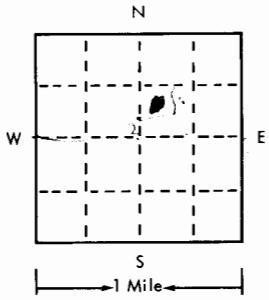

4 Well depth: 45 ft. Date of completion 1-29-75
Well diameter 2 in. 5

5 ☐ Cable tool ☒ Rotary ☐ Driven ☐ Dug
☐ Hollow rod ☐ Jetted ☐ Bored ☐ Reverse rotary

6 Use: ☐ Domestic ☐ Public supply ☐ Industry
☐ Irrigation ☐ Air conditioning ☐ Commercial
☐ Test well ☒ Oil field

7 Casing: Material: Plastic Height: above/below
Threaded ☐ Welded ☒ Surface 2 in.
Diam. Weight 47 lbs./ft 100
2 in. to 46 ft. depth Drive shoe? ☐ Yes ☒ No
___ in. to ___ ft. depth

2

Type and color of material	From	To
Clay	0	18
Sand	18	30
Gravel	30	45

(use a second sheet if needed)

8 Screen:
Manufacturer John Manville
Type PVC Dia. 2
Slot/gauze 25 Length 10
Set between 35 ft. and 45 ft.
Fittings:
Gravel pack ☒ Yes ☐ No Size range of material ___

9 Static water level:
14 ft. below land surface Date 1-29-75

10 Pumping level below land surfaces:
___ ft. after ___ hrs. pumping ___ g.p.m.
___ ft. after ___ hrs. pumping ___ g.p.m.
Estimated maximum yield ___ g.p.m.

11 Water sample submitted:
☐ Yes ☒ No Date ___

12 Well head completion:
☒ Pitless adapter 12 ☐ Inches above grade

13 Well grouted? ☒ Yes ☐ No
☐ Neat cement ☒ Bentonite ☐ ___
Depth: From 0 ft. to 10 ft.

14 Nearest source of possible contamination:
ft. 100 Direction West Type salt water
Well disinfected upon completion? ☐ Yes ☐ No

15 Pump: ☒ Not installed
Manufacturer's name ___
Model number ___ HP ___ Volts ___
Length of drop pipe ___ ft. capacity ___ g.m.p.
Type:
☐ Submersible ☐ Turbine
☐ Jet ☐ Reciprocating
☐ Certrifugal ☐ Other

16 Remarks: elevation

Topography:
☐ Hill
☒ Slope
☐ Upland
☐ Valley

17 Water well contractor's certification:
This well was drilled under my jurisdiction and this report is true to the best of my knowledge and belief.
Myers Waterwell 143
Business name License No.
Address Great Bend Ks
Signed Alfred A. Myers Date 1-29-75
Authorized representative

Forward the white, blue and pink copies to the Kansas State Dept. Of Health.

Form WWC-5

677-H

21 14 33 NW SW NE