


1 LOCATION OF WATER WELL:	Fraction	Section Number	Township Number	Range Number
County: <u>Pawnee</u>	$\frac{1}{4}$ NC $\frac{1}{4}$ NE $\frac{1}{4}$	16	21	15

Distance and direction from nearest town or city street address of well if located within city?
2 1/4 North, 6 3/4 East of Larned

2 WATER WELL OWNER: Don Sanders

RR #, St. Address, Box #: 150 East Forest Board of Agriculture, Division of Water Resources
 City, State, ZIP Code : Sterling, Ks. 67579 Application Number: 34,783

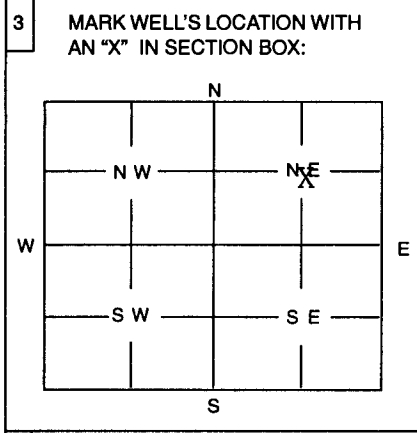

4 DEPTH OF WELL 30 ft

WELL'S STATIC WATER LEVEL 11 ft.

WELL WAS USED AS:

1 Domestic	5 Public Water Supply	9 Dewatering
2 <u>Irrigation</u>	6 Oil Field Water Supply	10 Monitoring Well
3 Feedlot	7 Domestic (Lawn & Garden)	11 Injection Well
4 Industrial	8 Air Conditioning	12 Other

Was a chemical / bacteriological sample submitted to Department? Yes No X.....
 If yes, mo/day/yr sample was submitted

Water Well Disinfected: Yes HTH No

5 TYPE OF BLANK CASING USED:

1 Steel 3 RMP (SR) 5 Wrought 7 Fiberglass 9 Other (Specify below)
 2 PVC 4 ABS 6 Asbestos-Cement 8 Concrete Tile

Blank casing diameter 16 in. Was casing pulled? Yes No X If yes, how much

Casing height above or below land surface 30 in.

6 GROUT PLUG MATERIAL: 1 Neat cement 2 Cement grout 3 Bentonite 4 Other hole plug

Grout Plug Intervals: From 11 ft. to 5 ft., From 5 ft. to 3 ft., From to ft.

What is the nearest source of possible contamination:

1 Septic tank	6 Seepage pit	11 Fuel storage	16 Other (specify below)
2 Sewer lines	7 Pit privy	12 Fertilizer storage	<u>None</u>
3 Watertight sewer lines	8 Sewage lagoon	13 Insecticide storage	
4 Lateral lines	9 Feedyard	14 Abandoned water well	
5 Cess Pool	10 Livestock pens	15 Oil well/Gas well	

Direction from well? How many feet?

FROM	TO	PLUGGING MATERIALS
30	11	Gravel
11	5	Hole plug
5	3	Cement
3	0	Top soil

7 CONTRACTOR'S OR LANDOWNER'S CERTIFICATION: This water well was plugged under my jurisdiction and was completed on (mo/day/year) 4-18-03 and this record is true to the best of my knowledge and belief. Kansas Water Well Contractor's License No. 134 This Water Well Record was completed on (mo/day/year) 4-28-03 under the business name of Rosencrantz- Bemis

by (signature) [Signature]

INSTRUCTIONS: Use typewriter or ball point pen. **Please press firmly and print clearly.** Please fill in blanks, underline or circle the correct answers. Send top three copies to Kansas Department of Health and Environment, Bureau of Water, Topeka, Kansas 66620-0001. Telephone: 785/296-3565. Send one to Water Well Owner and retain one for your records.