


1	LOCATION OF WATER WELL:	Fraction	Section Number	Township Number	Range Number
	County: <u>Pawnee</u>	$\frac{1}{4}$ NC $\frac{1}{4}$ NE $\frac{1}{4}$	<u>16</u>	<u>21</u>	<u>15</u>

Distance and direction from nearest town or city street address of well if located within city?
2 1/4 North, 6 3/4 East of Larned

2	WATER WELL OWNER: <u>Don Sanders</u>	RR #, St. Address, Box #: <u>150 East Forest</u>	Board of Agriculture, Division of Water Resources
	City, State, ZIP Code: <u>Sterling, Ks. 67579</u>	Application Number:	

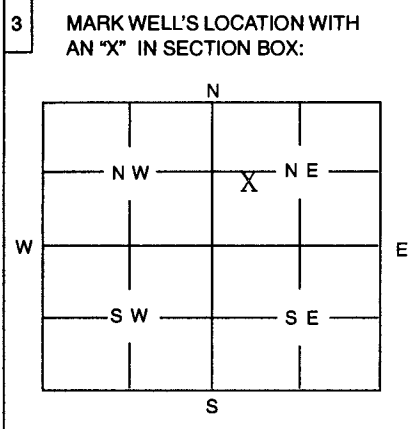

4 DEPTH OF WELL30..... ft

WELL'S STATIC WATER LEVEL11..... ft.

WELL WAS USED AS:

1 Domestic	5 Public Water Supply	9 Dewatering
2 Irrigation	6 Oil Field Water Supply	10 Monitoring Well
3 Feedlot	7 Domestic (Lawn & Garden)	11 Injection Well
4 Industrial	8 Air Conditioning	12 Other

Was a chemical / bacteriological sample submitted to Department? Yes No X.....
 If yes, mo/day/yr sample was submitted

Water Well Disinfected: Yes HTH No

5 TYPE OF BLANK CASING USED:

1 Steel	3 RMP (SR)	5 Wrought	7 Fiberglass	9 Other (Specify below)
2 PVC	4 ABS	6 Asbestos-Cement	8 Concrete Tile	

Blank casing diameter16..... in. Was casing pulled? Yes No X..... If yes, how much

Casing height above or below land surface36..... in.

6 GROUT PLUG MATERIAL: 1 Neat cement 2 Cement grout 3 Bentonite 4 Other Hole plug

Grout Plug Intervals: From 11 ft. to 5 ft., From 5 ft. to 3 ft., From to ft.

What is the nearest source of possible contamination:

1 Septic tank	6 Seepage pit	11 Fuel storage	16 Other (specify below)
2 Sewer lines	7 Pit privy	12 Fertilizer storage	<u>None</u>
3 Watertight sewer lines	8 Sewage lagoon	13 Insecticide storage	
4 Lateral lines	9 Feedyard	14 Abandoned water well	
5 Cess Pool	10 Livestock pens	15 Oil well/Gas well	

Direction from well? How many feet?

FROM	TO	PLUGGING MATERIALS
30	11	Gravel
11	5 XX	Hole plug
5	3	Cement
3	0	Top soil

7 CONTRACTOR'S OR LANDOWNER'S CERTIFICATION: This water well was plugged under my jurisdiction and was completed on (mo/day/year) 4-18-03 and this record is true to the best of my knowledge and belief. Kansas Water Well Contractor's License No. 134 This Water Well Record was completed on (mo/day/year) 4-28-03 under the business name of Rosencrantz- Bemis by (signature) Tara Alupe

INSTRUCTIONS: Use typewriter or ball point pen. Please press firmly and print clearly. Please fill in blanks, underline or circle the correct answers. Send top three copies to Kansas Department of Health and Environment, Bureau of Water, Topeka, Kansas 66620-0001. Telephone: 785/296-3565. Send one to Water Well Owner and retain one for your records.