


1	LOCATION OF WATER WELL:	Fraction	Section Number	Township Number	Range Number
	County: Pawnee	1/4 NC 1/4 NE 1/4	16	21	15

Distance and direction from nearest town or city street address of well if located within city?
 2 1/2 ~~W~~ North, 6 3/4 East of Larned

2 WATER WELL OWNER: Don Sanders
 RR #, St. Address, Box #: 150 East Forest Board of Agriculture, Division of Water Resources
 City, State, ZIP Code : Sterling, Ks. 67579 Application Number: 30,576

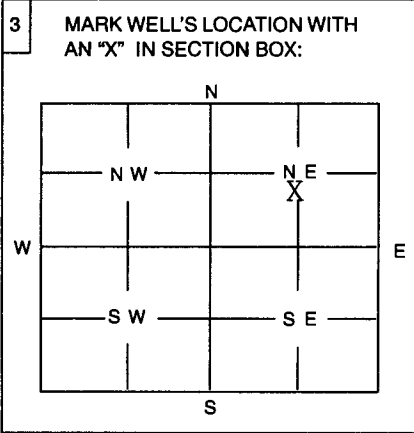

4 DEPTH OF WELL 30 ft
 WELL'S STATIC WATER LEVEL 11 ft.
 WELL WAS USED AS:
 1 Domestic 5 Public Water Supply 9 Dewatering
 2 Irrigation 6 Oil Field Water Supply 10 Monitoring Well
 3 Feedlot 7 Domestic (Lawn & Garden) 11 Injection Well
 4 Industrial 8 Air Conditioning 12 Other

Was a chemical / bacteriological sample submitted to Department? Yes No X.....
 If yes, mo/day/yr sample was submitted

Water Well Disinfected: Yes HTH No

5 TYPE OF BLANK CASING USED:
 1 Steel 3 RMP (SR) 5 Wrought 7 Fiberglass 9 Other (Specify below)
 2 PVC 4 ABS 6 Asbestos-Cement 8 Concrete Tile

Blank casing diameter 16 in. Was casing pulled? Yes No X..... If yes, how much

Casing height above or below land surface 30 in.

6 GROUT PLUG MATERIAL: 1 Neat cement 2 Cement grout 3 Bentonite 4 Other Hole plug.....
 Grout Plug Intervals: From 11 ft. to 5 ft., From 5 ft. to 3 ft., From to ft.

What is the nearest source of possible contamination:
 1 Septic tank 6 Seepage pit 11 Fuel storage 16 Other (specify below)
 2 Sewer lines 7 Pit privy 12 Fertilizer storage None

3 Watertight sewer lines 8 Sewage lagoon 13 Insecticide storage
 4 Lateral lines 9 Feedyard 14 Abandoned water well
 5 Cess Pool 10 Livestock pens 15 Oil well/Gas well

Direction from well? How many feet?

FROM	TO	PLUGGING MATERIALS
30	11	Gravel
11	5	Hole plug
5	3	Cement
3	0	Top soil

7 CONTRACTOR'S OR LANDOWNER'S CERTIFICATION: This water well was plugged under my jurisdiction and was completed on (mo/day/year) 4-18-03 and this record is true to the best of my knowledge and belief. Kansas Water Well Contractor's License No. 134 This Water Well Record was completed on (mo/day/year) 4-28-03 under the business name of Rosencrantz- Bemis

by (signature) *[Signature]*

INSTRUCTIONS: Use typewriter or ball point pen. Please press firmly and print clearly. Please fill in blanks, underline or circle the correct answers. Send top three copies to Kansas Department of Health and Environment, Bureau of Water, Topeka, Kansas 66620-0001. Telephone: 785/296-3565. Send one to Water Well Owner and retain one for your records.