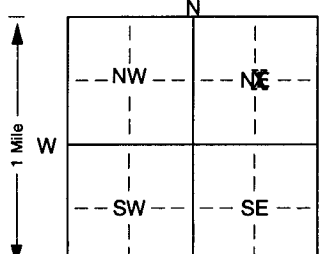


1 LOCATION OF WATER WELL:		Fraction		Section Number		Township Number		Range Number	
County: Pawnee		1/4 NC 1/4 NE 1/4		16		T 21 S		R 15 <del>24W</del>	
Distance and direction from nearest town or city street address of well if located within city?									
2 1/2 North, 6 3/4 East of Larned									
2 WATER WELL OWNER: Don Sanders									
RR#, St. Address, Box # : 150 East Forest					Board of Agriculture, Division of Water Resources				
City, State, ZIP Code : Sterling, Ks. 67579					Application Number: 30,576				
3 LOCATE WELL'S LOCATION WITH		4 DEPTH OF COMPLETED WELL: 65 ft. ELEVATION:							
AN "X" IN SECTION BOX:		Depth(s) Groundwater Encountered 1. ft. 2. ft. 3. ft.							
		WELL'S STATIC WATER LEVEL 11 ft. below land surface measured on mo/day/yr 4-9-03							
		Pump test data: Well water was 23 ft. after 2 hours pumping 350 gpm							
		Est. Yield 400 gpm: Well water was 25 ft. after 2 1/2 hours pumping 400 gpm							
		Bore Hole Diameter: 30 in. to 65 ft., and in. to ft.							
		WELL WATER TO BE USED AS: 5 Public water supply 8 Air conditioning 11 Injection well							
		1 Domestic 3 Feedlot 6 Oil field water supply 9 Dewatering 12 Other (Specify below)							
		2 Irrigation 4 Industrial 7 Domestic (lawn & garden) 10 Monitoring well							
Was a chemical/bacteriological sample submitted to Department? Yes. No. X; If yes, mo/day/yr sample was submitted									
Water Well Disinfected? Yes HTH No									
5 TYPE OF BLANK CASING USED:									
1 Steel 3 RMP (SR) 6 Asbestos-Cement 9 Other (specify below) CASING JOINTS: Glued. X Clamped.									
2 PVC 4 ABS 7 Fiberglass Welded									
Blank casing diameter 16 in. to 16 ft., Dia 16 in. to 58 ft., Dia in. to ft.									
Casing height above land surface 24 in., weight Sch 40 lbs./ft. Wall thickness or gauge No.									
TYPE OF SCREEN OR PERFORATION MATERIAL:									
1 Steel 3 Stainless steel 5 Fiberglass 7 PVC 10 Asbestos-cement									
2 Brass 4 Galvanized steel 6 Concrete tile 8 RMP (SR) 11 Other (specify)									
SCREEN OR PERFORATION OPENINGS ARE:									
1 Continuous slot 3 Mill slot 5 Gauzed wrapped 8 Saw cut 11 None (open hole)									
2 Louvered shutter 4 Key punched 6 Wire wrapped 9 Drilled holes									
7 Torch cut 10 Other (specify) ft.									
SCREEN-PERFORATED INTERVALS: From 65 ft. to 58 ft., From 28 ft. to 16 ft.									
GRAVEL PACK INTERVALS: From 65 ft. to 11 ft., From ft. to ft.									
6 GROUT MATERIAL: 1 Neat cement 2 Cement grout 3 Bentonite 4 Other hole plug									
Grout Intervals: From 11 ft. to 0 ft., From ft. to ft., From ft. to ft.									
What is the nearest source of possible contamination:									
1 Septic tank 4 Lateral lines 7 Pit privy 10 Livestock pens 14 Abandoned water well									
2 Sewer lines 5 Cess pool 8 Sewage lagoon 11 Fuel storage 15 Oil well/Gas well									
3 Watertight sewer lines 6 Seepage pit 9 Feedyard 12 Fertilizer storage 16 Other (specify below)									
Direction from well? How many feet? 134 This Water Well Record was completed on (mo/day/yr) 4-17-03									
under the business name of Rosencrantz- Bemis by (signature) Lora Albright									
INSTRUCTIONS: Use typewriter or ball point pen. PLEASE PRESS FIRMLY and PRINT clearly. Please fill in blanks, underline or circle the correct answers. Send top three copies to Kansas Department of Health and Environment, Bureau of Water, Topeka, Kansas 66620-0001. Telephone 785-296-5524. Send one to WATER WELL OWNER and retain one for your records. Fee of \$5.00 for each constructed well.									