


1 LOCATION OF WATER WELL:		Fraction	Section Number	Township Number	Range Number
County:	Pawnee	NE 1/4 SE 1/4 NE 1/4	5	T 21 S	R 15 W W

Distance and direction from nearest town or city street address of well if located within city?

Approx. 1/2 mile south of Pawnee Rock

2	WATER WELL OWNER:	Stephen Heit	
	RR#, St. Address, Box # :	Route 1	Board of Agriculture, Division of Water Resources
	City, State, ZIP Code :	Pawnee Rock, KS 67567	Application Number: not required

3	LOCATE WELL'S LOCATION WITH AN "X" IN SECTION BOX:	4	DEPTH OF COMPLETED WELL.....	37	ft.	ELEVATION:	unknown
			Depth(s) Groundwater Encountered	1	13	ft	2

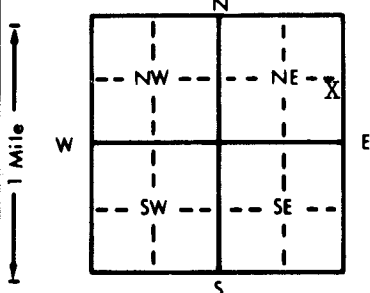

4 DEPTH OF COMPLETED WELL..... 37 ft. ELEVATION: unknown
 Depth(s) Groundwater Encountered 1..... 13 ft. 2..... ft. 3..... ft.
 WELL'S STATIC WATER LEVEL 13 ft. below land surface measured on mo/day/yr 6/6/88
 Pump test data: Well water was not ck'd ft. after hours pumping gpm
 Est. Yield unknown gpm: Well water was ft. after hours pumping gpm
 Bore Hole Diameter..... 9 in. to 35 ft., and in. to ft.
 WELL WATER TO BE USED AS: 5 Public water supply 8 Air conditioning 11 Injection well
 1 Domestic 3 Feedlot 6 Oil field water supply 9 Dewatering 12 Other (Specify below)
 2 Irrigation 4 Industrial 7 Lawn and garden only 10 Observation well
 Was a chemical/bacteriological sample submitted to Department? Yes..... No..... X.....; If yes, mo/day/yr sample was sub-
 mitted Water Well Disinfected? Yes X No

5	TYPE OF BLANK CASING USED:		5 Wrought iron	8 Concrete tile	CASING JOINTS: <u>Glued</u> <input checked="" type="checkbox"/> Clamped Welded Threaded
	1 Steel	3 RMP (SR)	6 Asbestos-Cement	9 Other (specify below)	
	2 PVC	4 ABS	7 Fiberglass		

Blank casing diameter . 5 . in. to . 25 . ft. Dia in. to ft. Dia in. to ft.
Casing height above land surface 24 . in. weight 2.277 . lbs./ft. Wall thickness or gauge No. 214

TYPE OF SCREEN OR PERFORATION MATERIAL:			<u>7 PVC</u>	10 Asbestos-cement
1 Steel	3 Stainless steel	5 Fiberglass	8 RMP (SR)	11 Other (specify)
2 Brass	4 Galvanized steel	6 Concrete tile	9 ABS	12 None used (open hole)

SCREEN OR PERFORATION OPENINGS ARE:

1 Continuous slot	3 <u>Mill slot</u>	5 Gauzed wrapped	8 Saw cut	11 None (open hole)
2 Louvered shutter	4 Key punched	6 Wire wrapped	9 Drilled holes	
		7 Torch cut	10 Other (specify)	

SCREEN-PERFORATED INTERVALS:	From 25	ft. to 35	ft., From	ft. to	ft.
	From	ft. to	ft., From	ft. to	ft.
GRAVEL PACK INTERVALS:	From 20	ft. to 35	ft., From	ft. to	ft.
Annular Fill	From 18	ft. to 20	ft., From	ft. to	ft.


6 GROUT MATERIAL:		1 Neat cement	2 Cement grout	3 Bentonite	4 Other
Grout Intervals:	From	0	ft. to	18	ft.
	From		ft. to		ft.

What is the nearest source of possible contamination:

1 <u>Septic tank</u>	4 Lateral lines	7 Pit privy	10 Livestock pens	14 Abandoned water well
2 Sewer lines	5 Cess pool	8 Sewage lagoon	11 Fuel storage	15 Oil well/Gas well
3 Watertight sewer lines	6 Seepage pit	9 Feedyard	12 Fertilizer storage	16 Other (specify below)
			13 Insecticide storage

Direction from well? north How many feet? 200

[illegible]

7 CONTRACTOR'S OR LANDOWNER'S CERTIFICATION: This water well was (1) constructed, (2) reconstructed, or (3) plugged under my jurisdiction and was completed on (mo/day/year) 6/6/88 and this record is true to the best of my knowledge and belief. Kansas Water Well Contractor's License No. 185 This Water Well Record was completed on (mo/day/yr) 6/16/88 under the business name of Clarke Well & Equipment, Inc. by (signature) 

INSTRUCTIONS: Use typewriter or ball point pen. PLEASE PRESS FIRMLY and PRINT clearly. Please fill in blanks, underline or circle the correct answers. Send top three copies to Kansas Department of Health and Environment, Bureau of Water Protection, Topeka, Kansas 66620-7320, Telephone: 913-862-9360. Send one to WATER WELL OWNER and retain one for your records.

OFFICE USE ONLY

21

51

SEC. 5

 $\frac{1}{2}$

1/4

 $\frac{1}{2}$