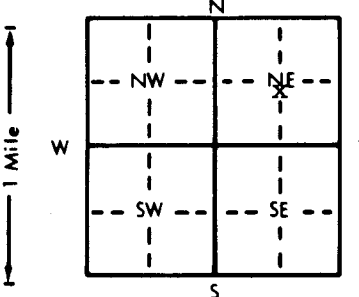


1 LOCATION OF WATER WELL:		Fraction 120' So. of Pivot		Section Number	Township Number	Range Number
County: Pawnee		1/4 1/4 NE 1/4		16	T 21 S	R 15 EW
Distance and direction from nearest town or city street address of well if located within city? 5 3/4 mile east and 2 3/4 mile north of Larned, KS						
2 WATER WELL OWNER: Clarence Mermis						
RR#, St. Address, Box #: Route 1 Board of Agriculture, Division of Water Resources						
City, State, ZIP Code: Great Bend, KS 67530 Application Number: not available						
3 LOCATE WELL'S LOCATION WITH AN "X" IN SECTION BOX:		4 DEPTH OF COMPLETED WELL: 34 ft. ELEVATION: unknown				
		Depth(s) Groundwater Encountered 1. 11 ft. 2. ft. 3. ft.				
		WELL'S STATIC WATER LEVEL 11 ft. below land surface measured on mo/day/yr 4/24/81				
		Pump test data: Well water was not ckd. after hours pumping gpm				
		Est. Yield 200 gpm: Well water was ft. after hours pumping gpm				
Bore Hole Diameter 24 in. to 34 ft. and in. to ft.						
WELL WATER TO BE USED AS: 5 Public water supply 8 Air conditioning 11 Injection well						
1 Domestic 3 Feedlot 6 Oil field water supply 9 Dewatering 12 Other (Specify below)						
2 Irrigation 4 Industrial 7 Lawn and garden only 10 Observation well						
Was a chemical/bacteriological sample submitted to Department? Yes No X If yes, mo/day/yr sample was submitted						
Water Well Disinfected? Yes No X						
5 TYPE OF BLANK CASING USED: 5 Wrought iron 8 Concrete tile CASING JOINTS: Glued Clamped						
1 Steel 3 RMP (SR) 6 Asbestos-Cement 9 Other (specify below) Welded XX						
2 PVC 4 ABS 7 Fiberglass Threaded						
Blank casing diameter 16 in. to 34 ft. Dia in. to ft. Dia in. to ft.						
Casing height above land surface 24 in., weight 31.75 lbs./ft. Wall thickness or gauge No. 188						
TYPE OF SCREEN OR PERFORATION MATERIAL: 7 PVC 10 Asbestos-cement						
1 Steel 3 Stainless steel 5 Fiberglass 8 RMP (SR) 11 Other (specify)						
2 Brass 4 Galvanized steel 6 Concrete tile 9 ABS 12 None used (open hole)						
SCREEN OR PERFORATION OPENINGS ARE: 5 Gauzed wrapped 8 Saw cut 11 None (open hole)						
1 Continuous slot 3 Mill slot 6 Wire wrapped 9 Drilled holes						
2 Louvered shutter 4 Key punched 7 Torch cut 10 Other (specify) Doerr Bridge Slot						
SCREEN-PERFORATED INTERVALS: From 14 ft. to 34 ft. From ft. to ft.						
GRAVEL PACK INTERVALS: From 10 ft. to 33 ft. From ft. to ft.						
6 GROUT MATERIAL: 1 Neat cement 2 Cement grout 3 Bentonite 4 Other						
Grout Intervals: From 0 ft. to 10 ft. From ft. to ft. From ft. to ft.						
What is the nearest source of possible contamination: 10 Livestock pens 14 Abandoned water well						
1 Septic tank 4 Lateral lines 7 Pit privy 11 Fuel storage 15 Oil well/Gas well						
2 Sewer lines 5 Cess pool 8 Sewage lagoon 12 Fertilizer storage 16 Other (specify below)						
3 Watertight sewer lines 6 Seepage pit 9 Feedyard 13 Insecticide storage FIELD						
Direction from well? ALL How many feet? n/a						
FROM	TO	LITHOLOGIC LOG		FROM	TO	LITHOLOGIC LOG
0	6	Topsoil & brown clay				
6	7	Fine sand				
7	24	Fine-med sand & gravel, some coarse streaks brown & blk sandy clay				
		13-15				
24	28	Yellow, tan & light gray clay				
28	29	Fine-med sand & gravel				
29	33	Tan clay				
		THIS IS WELL #4 OF A 4 WELL MANIFOLD SYSTEM				
7 CONTRACTOR'S OR LANDOWNER'S CERTIFICATION: This water well was (1) constructed, (2) reconstructed, or (3) plugged under my jurisdiction and was completed on (mo/day/year) 4/24/81 and this record is true to the best of my knowledge and belief. Kansas Water Well Contractor's License No. 185 This Water Well Record was completed on (mo/day/yr) 4/27/81 under the business name of CLARKE WELL & EQ., INC. by (signature)						
INSTRUCTIONS: Use typewriter or ball point pen, PLEASE PRESS FIRMLY and PRINT clearly. Please fill in blanks, underline or circle the correct answers. Send top three copies to Kansas Department of Health and Environment, Division of Environment, Environmental Geology Section, Topeka, KS 66620. Send one to WATER WELL OWNER and retain one for your records.						