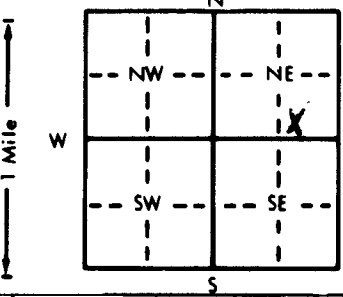


1 LOCATION OF WATER WELL:		Fraction	Section Number	Township Number	Range Number
County: Pawnee		SW 1/4 SE 1/4 NE 1/4	25	T 21 S	R 15 E/W
Distance and direction from nearest town or city street address of well if located within city? 8 3/4 east 1/4 north of Larned, Ks.					
2 WATER WELL OWNER:		Allen Drilling		John Woelk	
RR#, St. Address, Box # :		Box 1389		Rozel, Ks.	
City, State, ZIP Code :		Great Bend, Ks. 67530		Board of Agriculture, Division of Water Resources Application Number: T86-87	
3 LOCATE WELL'S LOCATION WITH AN "X" IN SECTION BOX:		4 DEPTH OF COMPLETED WELL: 80 ft. ELEVATION:			
<div style="text-align: center;"></div>		Depth(s) Groundwater Encountered 1. ft. 2. ft. 3. ft.			
		WELL'S STATIC WATER LEVEL 28 ft. below land surface measured on mo/day/yr ... 2-11-86			
		Pump test data: Well water was ft. after hours pumping gpm			
		Est. Yield ... gpm: Well water was ft. after hours pumping gpm			
		Bore Hole Diameter ... 10 in. to ... 80 ft., and ... in. to ... ft.			
TYPE OF BLANK CASING USED:		CASING JOINTS: Glued <input checked="" type="checkbox"/> Clamped			
1 Steel		3 RMP (SR)	5 Wrought iron	8 Concrete tile	Welded
2 PVC		4 ABS	6 Asbestos-Cement	9 Other (specify below)	Threaded
Blank casing diameter 5 in. to 60 ft., Dia. in. to ft., Dia. in. to ft.		7 Fiberglass			
Casing height above land surface 18 in., weight lbs./ft. Wall thickness or gauge No. ... 258					
TYPE OF SCREEN OR PERFORATION MATERIAL:		7 PVC			
1 Steel		3 Stainless steel	5 Fiberglass	8 RMP (SR)	10 Asbestos-cement
2 Brass		4 Galvanized steel	6 Concrete tile	9 ABS	11 Other (specify)
SCREEN OR PERFORATION OPENINGS ARE:		12 None used (open hole)			
1 Continuous slot		3 Mill slot	5 Gauzed wrapped	8 Saw cut	11 None (open hole)
2 Louvered shutter		4 Key punched	6 Wire wrapped	9 Drilled holes	
SCREEN-PERFORATED INTERVALS:		7 Torch cut			
From 60 ft. to 80 ft., From ft. to ft.		10 Other (specify)			
From ft. to ft., From ft. to ft.					
GRAVEL PACK INTERVALS:					
From 10 ft. to 80 ft., From ft. to ft.					
From ft. to ft., From ft. to ft.					
6 GROUT MATERIAL:		1 Neat cement			
Grout intervals: From 10 ft. to 0 ft., From ft. to ft., From ft. to ft.		2 Cement grout			
What is the nearest source of possible contamination:		3 Bentonite			
1 Septic tank		4 Other			
2 Sewer lines		5 Livestock pens			
3 Watertight sewer lines		6 Fuel storage			
4 Lateral lines		7 Pit privy			
5 Cess pool		8 Sewage lagoon			
6 Seepage pit		9 Feedyard			
Direction from well? South east		10 Insecticide storage			
		11 Abandoned water well			
		12 Oil well/Gas well			
		13 Other (specify below)			
		How many feet? 130			
FROM	TO	LITHOLOGIC LOG	FROM	TO	LITHOLOGIC LOG
0	3	Top soil			
3	7	Sandy clay			
7	22	Brown clay			
22	31	Fine sand			
31	58	Sand and gravel			
58	62	Clay			
62	80	Sand and gravel			
7 CONTRACTOR'S OR LANDOWNER'S CERTIFICATION: This water well was (1) constructed, (2) reconstructed, or (3) plugged under my jurisdiction and was completed on (mo/day/year) 2-11-86 and this record is true to the best of my knowledge and belief. Kansas Water Well Contractor's License No. ... 134 This Water Well Record was completed on (mo/day/yr) ... 2-26-86 under the business name of Rosencrantz-Bemis by (signature) Fredia Rodon					
INSTRUCTIONS: Use typewriter or ball point pen. PLEASE PRESS FIRMLY and PRINT clearly. Please fill in blanks, underline or circle the correct answers. Send top three copies to Kansas Department of Health and Environment, Office of Oil Field and Environmental Geology, Regulation and Permitting Section, Topeka, Kansas 66620-7500, Telephone: 913-862-9360. Send one to WATER WELL OWNER and retain one for your records.					