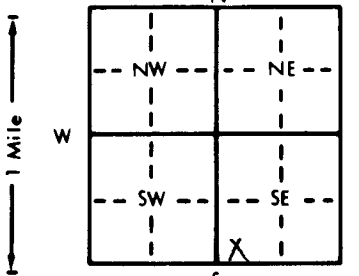


1 LOCATION OF WATER WELL: County: <u>Pawnee</u>		Fraction SW $\frac{1}{4}$ SW $\frac{1}{4}$ SE $\frac{1}{4}$		Section Number <u>25</u>	Township Number T <u>21</u> S	Range Number R <u>16</u> EW
Distance and direction from nearest town or city street address of well if located within city? <u>3 1/8 East of Larned, Ks.</u>						
2 WATER WELL OWNER: RR#, St. Address, Box # : City, State, ZIP Code :		Ward Feed Yard Box H Larned, Ks. 67550 Board of Agriculture, Division of Water Resources Application Number:				
3 LOCATE WELL'S LOCATION WITH AN "X" IN SECTION BOX: <div style="text-align: center;"></div>		4 DEPTH OF COMPLETED WELL ft. ELEVATION: ft. Depth(s) Groundwater Encountered 1. ft. 2. ft. 3. ft. WELL'S STATIC WATER LEVEL <u>14</u> ft. below land surface measured on mo/day/yr <u>7-15-95</u> Pump test data: Well water was ft. after hours pumping gpm Est. Yield gpm: Well water was ft. after hours pumping gpm Bore Hole Diameter <u>WAS</u> in. to ft., and in. to ft. WELL WATER TO BE USED AS: 5 Public water supply 8 Air conditioning 11 Injection well 1 Domestic 3 Feedlot 6 Oil field water supply 9 Dewatering 12 Other (Specify below) <u>2 Irrigation</u> 4 Industrial 7 Lawn and garden only 10 Monitoring well Was a chemical/bacteriological sample submitted to Department? Yes.....No..... <u>X</u>; If yes, mo/day/yr sample was submitted Water Well Disinfected? Yes <u>hth</u> No				
5 TYPE OF BLANK CASING USED: 1 Steel 3 RMP (SR) 5 Wrought iron 8 Concrete tile CASING JOINTS: Glued Clamped 2 PVC 4 ABS 6 Asbestos-Cement 9 Other (specify below) Welded 7 Fiberglass Threaded Blank casing diameter <u>16</u> in. to ft., Dia in. to ft., Dia in. to ft. Casing height above land surface in., weight lbs./ft. Wall thickness or gauge No. TYPE OF SCREEN OR PERFORATION MATERIAL: 7 PVC 10 Asbestos-cement 1 Steel 3 Stainless steel 5 Fiberglass 8 RMP (SR) 11 Other (specify) 2 Brass 4 Galvanized steel 6 Concrete tile 9 ABS 12 None used (open hole) SCREEN OR PERFORATION OPENINGS ARE: 5 Gauzed wrapped 8 Saw cut 11 None (open hole) 1 Continuous slot 3 Mill slot 6 Wire wrapped 9 Drilled holes 2 Louvered shutter 4 Key punched 7 Torch cut 10 Other (specify) SCREEN-PERFORATED INTERVALS: From ft. to ft., From ft. to ft. From ft. to ft., From ft. to ft. GRAVEL PACK INTERVALS: From ft. to ft., From ft. to ft. From ft. to ft., From ft. to ft.						
6 GROUT MATERIAL: 1 Neat cement 2 Cement grout 3 Bentonite 4 Other Grout Intervals: From ft. to ft., From ft. to ft., From ft. to ft. What is the nearest source of possible contamination: 10 Livestock pens 14 Abandoned water well 1 Septic tank 4 Lateral lines 7 Pit privy 11 Fuel storage 15 Oil well/Gas well 2 Sewer lines 5 Cess pool 8 Sewage lagoon 12 Fertilizer storage 16 Other (specify below) 3 Watertight sewer lines 6 Seepage pit 9 Feedyard 13 Insecticide storage Direction from well? How many feet?						
FROM		TO		LITHOLOGIC LOG		FROM
56		14		Sand and gravel		TO
14		3		Cement		PLUGGING INTERVALS
7 CONTRACTOR'S OR LANDOWNER'S CERTIFICATION: This water well was (1) constructed, (2) reconstructed, or (3) <u>plugged under</u> my jurisdiction and was completed on (mo/day/year) <u>7-15-95</u> and this record is true to the best of my knowledge and belief. Kansas Water Well Contractor's License No. <u>134</u> This Water Well Record was completed on (mo/day/yr) <u>7-26-95</u> under the business name of <u>Rosencrantz-Bemis</u> by (signature) <u>Fredia Jackson</u>						