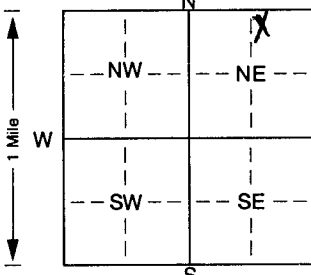


007263

WATER WELL RECORD Form WWC-5 KSA 82a-1212 ID No.

CM2508

1 LOCATION OF WATER WELL:		Fraction	Section Number	Township Number	Range Number
County: <u>Pawnee</u>		<u>NW 1/4 NE 1/4 NE 1/4</u>	<u>32</u>	<u>T 21 S</u>	<u>R 16 EW</u>
Distance and direction from nearest town or city street address of well if located within city? <u>215 W. 14th St., Larned</u>					
2 WATER WELL OWNER:					
RR#, St. Address, Box # : <u>Coastal Mart, Inc.</u>					
City, State, ZIP Code : <u>Nine Greenway Plaza</u>					
<u>Houston, TX 77046</u>					
Board of Agriculture, Division of Water Resources Application Number:					
3 LOCATE WELL'S LOCATION WITH		4 DEPTH OF COMPLETED WELL			
AN "X" IN SECTION BOX:		ft. ELEVATION:			
		Depth(s) Groundwater Encountered 1. ft. 2. ft. 3. ft.			
		WELL'S STATIC WATER LEVEL ft. below land surface measured on mo/day/yr			
		Pump test data: Well water was ft. after hours pumping gpm			
		Est. Yield gpm: Well water was ft. after hours pumping gpm			
		Bore Hole Diameter. . . <u>8.5</u> in. to <u>40</u> ft., and in. to ft.			
		WELL WATER TO BE USED AS: 5 Public water supply 8 Air conditioning 11 Injection well			
		1 Domestic 3 Feedlot 6 Oil field water supply 9 Dewatering 12 Other (Specify below)			
		2 Irrigation 4 Industrial 7 Domestic (lawn & garden) <u>10 Monitoring well</u> <u>mw-3</u>			
Was a chemical/bacteriological sample submitted to Department? Yes. No. <u>X</u> ; If yes, mo/day/yr sample was submitted					
Water Well Disinfected? Yes No <u>X</u>					
5 TYPE OF BLANK CASING USED:					
1 Steel 3 RMP (SR) 5 Wrought iron 8 Concrete tile CASING JOINTS: Glued. Clamped.					
2 <u>PVC</u> 4 ABS 6 Asbestos-Cement 9 Other (specify below) Welded					
Blank casing diameter . . . <u>2</u> in. to <u>25</u> ft., Dia in. to ft., Dia in. to ft.					
Casing height above land surface. <u>Flush</u> in., weight . . . <u>70.3</u> lbs./ft. Wall thickness or gauge No. <u>Sch 40</u>					
TYPE OF SCREEN OR PERFORATION MATERIAL:					
1 Steel 3 Stainless steel 5 Fiberglass 8 RMP (SR) 10 Asbestos-cement					
2 Brass 4 Galvanized steel 6 Concrete tile 9 ABS 11 Other (specify)					
12 None used (open hole)					
SCREEN OR PERFORATION OPENINGS ARE:					
1 Continuous slot 3 <u>Mill slot</u> 5 Gauzed wrapped 8 Saw cut 11 None (open hole)					
2 Louvered shutter 4 Key punched 6 Wire wrapped 9 Drilled holes					
7 Torch cut 10 Other (specify) ft.					
SCREEN-PERFORATED INTERVALS: From . . . <u>25</u> ft. to . . . <u>40</u> ft., From ft. to ft.					
From ft. to ft., From ft. to ft.					
GRAVEL PACK INTERVALS: From . . . <u>23</u> ft. to . . . <u>40</u> ft., From ft. to ft.					
From ft. to ft., From ft. to ft.					
6 GROUT MATERIAL: 1 Neat cement 2 Cement grout 3 <u>Bentonite</u> 4 Other					
Grout Intervals: From . . . <u>1</u> ft. to <u>23</u> ft., From ft. to ft., From ft. to ft.					
What is the nearest source of possible contamination:					
1 Septic tank 4 Lateral lines 7 Pit privy 10 Livestock pens 14 Abandoned water well					
2 Sewer lines 5 Cess pool 8 Sewage lagoon 11 <u>Fuel storage</u> 15 Oil well/Gas well					
3 Watertight sewer lines 6 Seepage pit 9 Feedyard 12 Fertilizer storage 16 Other (specify below)					
13 Insecticide storage					
Direction from well? <u>Northwest</u> How many feet? <u>10</u>					
FROM	TO	LITHOLOGIC LOG	FROM	TO	PLUGGING INTERVALS
0	5	Clay			
5	10	Silty Clay			
10	15	Sandy Silty Clay			
15	25	Silty Clay			
25	35	Silty Clay			
35	40	Silty Clay & gravel			

7 CONTRACTOR'S OR LANDOWNER'S CERTIFICATION: This water well was (1) constructed, (2) reconstructed, or (3) plugged under my jurisdiction and was completed on (mo/day/year) 12/5/00 and this record is true to the best of my knowledge and belief. Kansas Water Well Contractor's Licence No. 531 This Water Well Record was completed on (mo/day/yr) 1/4/01 under the business name of Geotechnical Services, Inc. by (signature) William M. Shin