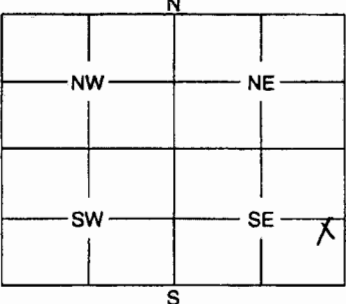


1	LOCATION OF WATER WELL: County: Pawnee	Fraction NE ¼ SE ¼ SE ¼	Section 32	Number	Township 21	Number	Range 16	Number																											
Distance and direction from nearest town or city street address of well if located within city? 103 E. 3rd St., Larned																																			
2	WATER WELL OWNER: Pawnee County Coop RR #, St. Address, Box #: 103 E. 3rd Street City, State, ZIP Code : Larned, KS 67550																																		
Board of Agriculture, Division of Water Resources Application Number:																																			
3	MARK WELL'S LOCATION WITH AN "X" IN SECTION BOX: <div style="text-align: center;">  </div>		4 DEPTH OF WELL 24.7 ft. WELL'S STATIC WATER LEVEL 21.11 ft. WELL WAS USED AS: <div style="display: flex; justify-content: space-between;"> <div> 1 Domestic 2 Irrigation 3 Feedlot 4 Industrial </div> <div> 5 Public Water Supply 6 Oil Field Water Supply 7 Domestic (Lawn & Garden) 8 Air Conditioning </div> <div> 9 Dewatering 10 Monitoring Well 11 Injection Well 12 Other </div> </div> Was a chemical / bacteriological sample submitted to Department? Yes No <input checked="" type="checkbox"/> If yes, mo/day/yr sample was submitted Water Well Disinfected: Yes No <input checked="" type="checkbox"/>																																
5	TYPE OF BLANK CASING USED: <div style="display: flex; justify-content: space-between;"> <div>1 Steel ● PVC</div> <div>3 RMP (SR) 4 ABS</div> <div>5 Wrought 6 Asbestos-Cement</div> <div>7 Fiberglass 8 Concrete Tile</div> <div>9 Other (Specify below)</div> </div> Blank casing diameter 2 in. Was casing pulled? Yes No <input checked="" type="checkbox"/> If yes, how much Casing height above or below land surface in.																																		
6	GROUT PLUG MATERIAL: 1 Neat cement 2 Cement grout ● Bentonite ● Other ..Native soil..... Grout Plug Intervals: From 0 ft. to 3 ft., From 3 ft. to 24.7 ft., From to ft. What is the nearest source of possible contamination: <div style="display: flex; justify-content: space-between;"> <div> 1 Septic tank 2 Sewer lines 3 Watertight sewer lines 4 Lateral lines 5 Cess pool </div> <div> 6 Seepage pit 7 Pit privy 8 Sewage lagoon 9 Feedyard 10 Livestock pens </div> <div> 11 Fuel storage 12 Fertilizer storage 13 Insecticide storage 14 Abandoned water well 15 Oil well/Gas well </div> <div> 16 Other (specify below) </div> </div> Direction from well? How many feet?																																		
<table border="1" style="width:100%; border-collapse: collapse;"> <thead> <tr> <th style="width:10%;">FROM</th> <th style="width:10%;">TO</th> <th style="width:80%;">PLUGGING MATERIALS</th> </tr> </thead> <tbody> <tr> <td>0</td> <td>3</td> <td>Native soil</td> </tr> <tr> <td>3</td> <td>24.7</td> <td>Bentonite (2")</td> </tr> <tr><td> </td><td> </td><td> </td></tr> <tr><td> </td><td> </td><td> </td></tr> <tr><td> </td><td> </td><td> </td></tr> <tr><td> </td><td> </td><td> </td></tr> <tr><td> </td><td> </td><td> </td></tr> <tr><td> </td><td> </td><td> </td></tr> </tbody> </table>									FROM	TO	PLUGGING MATERIALS	0	3	Native soil	3	24.7	Bentonite (2")																		
FROM	TO	PLUGGING MATERIALS																																	
0	3	Native soil																																	
3	24.7	Bentonite (2")																																	
Casing removed to 3' bgs MW1 KDHE #U1 073 00061 / GeoCore #1278																																			
7	CONTRACTOR'S OF LANDOWNER'S CERTIFICATION: This water well was plugged under my jurisdiction and was completed on (mo/day/year) 3/20/2007 and this record is true to the best of my knowledge and belief. Kansas Water Well Contractor's License No. 527 This Water Well Record was completed on (mo/day/year) 4/5/2007 under the business name of GeoCore, Inc. by (signature) <i>[Signature]</i>																																		
INSTRUCTIONS: Use typewriter or ball point pen. Please press firmly and print clearly. Please fill in blanks, underline or circle the correct answers. Send top three copies to Kansas Department of Health and Environment, Bureau of Water, Geology Section, 1000 SW Jackson St., Ste. 420, Topeka, Kansas 66612-1367. Telephone: 785/296-5522. Send one to Water Well Owner and retain one for your records.																																			