


1 LOCATION OF WATER WELL: County: Pawnee Fraction NE 1/4 SE 1/4 SE 1/4 Section Number 32 Township Number T 21 S Range Number R 16 EW

Distance and direction from nearest town or city street address of well if located within city?

103 East 3rd Street, Larned, Kansas

2 WATER WELL OWNER: Pawnee Co. Coop RR#, St. Address, Box #: 103 East 3rd Street City, State, ZIP Code: Larned, Ks. 67550 Board of Agriculture, Division of Water Resources Application Number:

3 LOCATE WELL'S LOCATION WITH AN "X" IN SECTION BOX:

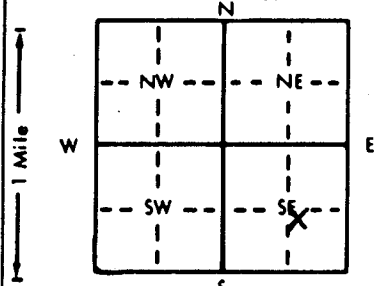

4 DEPTH OF COMPLETED WELL: 30 ft. ELEVATION: Depth(s) Groundwater Encountered 1. 20 ft. 2. 3. ft. 3. ft. WELL'S STATIC WATER LEVEL: 16.30 ft. below TOC measured on mo/day/yr 03-16-93 Pump test data: Well water was ... ft. after ... hours pumping ... gpm Est. Yield ... gpm: Well water was ... ft. after ... hours pumping ... gpm Bore Hole Diameter: 7 7/8 in. to 30 ft. and ... in. to ... ft. WELL WATER TO BE USED AS: 5 Public water supply 8 Air conditioning 11 Injection well 1 Domestic 3 Feedlot 6 Oil field water supply 9 Dewatering 12 Other (Specify below) 2 Irrigation 4 Industrial 7 Lawn and garden only 10 Monitoring well Was a chemical/bacteriological sample submitted to Department? Yes No [checked] If yes, mo/day/yr sample was submitted Water Well Disinfected? Yes No [checked]

5 TYPE OF BLANK CASING USED: 1 Steel 2 PVC [checked] 3 RMP (SR) 4 ABS 5 Wrought iron 6 Asbestos-Cement 7 Fiberglass 8 Concrete tile 9 Other (specify below) CASING JOINTS: Glued Clamped Welded Threaded [checked] Blank casing diameter: 2 in. to 15 ft. Dia. in. to ... ft. Dia. in. to ... ft. Casing height above land surface: -3 in., weight ... lbs./ft. Wall thickness or gauge No. Sch. 40 TYPE OF SCREEN OR PERFORATION MATERIAL: 1 Steel 2 Brass 3 Stainless steel 4 Galvanized steel 5 Fiberglass 6 Concrete tile 7 PVC [checked] 8 RMP (SR) 9 ABS 10 Asbestos-cement 11 Other (specify) 12 None used (open hole) SCREEN OR PERFORATION OPENINGS ARE: 1 Continuous slot 2 Louvered shutter 3 Mill slot [checked] 4 Key punched 5 Gauzed wrapped 6 Wire wrapped 7 Torch cut 8 Saw cut 9 Drilled holes 10 Other (specify) 11 None (open hole) SCREEN-PERFORATED INTERVALS: From 15 ft. to 30 ft., From ... ft. to ... ft. GRAVEL PACK INTERVALS: From 13 ft. to 30 ft., From ... ft. to ... ft.

6 GROUT MATERIAL: 1 Neat cement 2 Cement grout [checked] 3 Bentonite 4 Other Grout Intervals: From 0 ft. to 6 ft., From 6 ft. to 13 ft., From ... ft. to ... ft. What is the nearest source of possible contamination: 1 Septic tank 2 Sewer lines 3 Watertight sewer lines 4 Lateral lines 5 Cess pool 6 Seepage pit 7 Pit privy 8 Sewage lagoon 9 Feedyard 10 Livestock pens 11 Fuel storage [checked] 12 Fertilizer storage 13 Insecticide storage 14 Abandoned water well 15 Oil well/Gas well 16 Other (specify below)

FROM	TO	LITHOLOGIC LOG	FROM	TO	PLUGGING INTERVALS
0	6"	gravel (fill)			
6"	5'	brown silty clay			
5	7	grey brown silty clay			OB1
7	23	fine to coarse sand/fine to medium gravel			
23	23.5	brown silty clay			
23.5	26.5	fine to coarse sand/fine to coarse gravel			
26.5	30	brown silty clay			

7 CONTRACTOR'S OR LANDOWNER'S CERTIFICATION: This water well was (1) constructed, (2) reconstructed, or (3) plugged under my jurisdiction and was completed on (mo/day/year) 02-26-93 and this record is true to the best of my knowledge and belief. Kansas Water Well Contractor's License No. 527 This Water Well Record was completed on (mo/day/yr) 03-17-93 under the business name of GeoCore Services, Inc. by (signature) Dal A. Holt