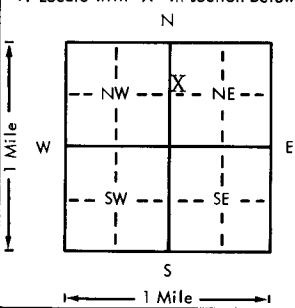


USE TYPEWRITER OR BALL  
POINT PEN-PRESS FIRMLY,  
PRINT CLEARLY.

WATER WELL RECORD  
KSA 82a-1201-1215

Kansas Department of Health and  
Environment-Division of Environment  
(Water well Contractors)  
Topeka, Kansas 66620

1. Location of well:	County <b>Pawnee</b>	Fraction <b>SW 1/4 NW 1/4 NE 1/4</b>	Section number <b>33</b>	Township number <b>T 21 S</b>	Range number <b>R 16 E</b>
2. Distance and direction from nearest town or city: <b>1/4 mile east of Larned, KS</b> Street address of well location if in city:			3. Owner of well: <b>Ed Westhoff</b> R.R. or street: <b>802 East 12th</b> City, state, zip code: <b>Larned, KS 67550</b>		
4. Locate with "X" in section below: 			Sketch map:		
5. Type and color of material			From	To	6. Bore hole dia. <b>18</b> in. Completion date <b>10-12-78</b> Well depth <b>63</b> ft.
Top soil			0	3	7. <input type="checkbox"/> Cable tool <input type="checkbox"/> Rotary <input type="checkbox"/> Driven <input type="checkbox"/> Dug <input type="checkbox"/> Hollow rod <input type="checkbox"/> Jetted <input type="checkbox"/> Bored <input checked="" type="checkbox"/> Reverse rotary
Brown clay			3	12	8. Use: <input type="checkbox"/> Domestic <input type="checkbox"/> Public supply <input type="checkbox"/> Industry <input checked="" type="checkbox"/> Irrigation <input type="checkbox"/> Air conditioning <input type="checkbox"/> Stock <input type="checkbox"/> Lawn <input type="checkbox"/> Oil field water <input type="checkbox"/> Other
Sand & gravel & clay streaks at 26' to 28' and 37' to 38'			12	42	9. Casing: Material <b>Steel</b> Height <b>Above</b> or below Threaded <input type="checkbox"/> Welded <input checked="" type="checkbox"/> Surface <b>12</b> in. RMP <input type="checkbox"/> PVC <input type="checkbox"/> Weight <b>20.24</b> lbs./ft. Dia. <b>10 3/4</b> in. to <b>31</b> ft. depth Wall Thickness: inches or Dia. <input type="checkbox"/> in. to <input type="checkbox"/> ft. depth gage No. <b>7 ga.</b>
Brown clay			42	45	10. Screen: Manufacturer's name <b>Doerr</b> Type <b>Double-slot</b> Dia. <b>10 3/4"</b> Slot gauge <b>1/8"</b> Length <b>32'</b> Set between <b>31</b> ft. and <b>63</b> ft. ft. and <input type="checkbox"/> ft. Gravel pack? <b>Yes</b> Size range of material <b>3/8-200</b>
Sand & gravel			45	62	11. Static water level: <input type="checkbox"/> mo./day/yr. <b>25</b> ft. below land surface Date <b>10/12/78</b>
Brown clay			62	63	12. Pumping level below land surface: <b>not checked</b> <input type="checkbox"/> ft. after <input type="checkbox"/> hrs. pumping <input type="checkbox"/> g.p.m. <input type="checkbox"/> ft. after <input type="checkbox"/> hrs. pumping <input type="checkbox"/> g.p.m. Estimated maximum yield <input type="checkbox"/> g.p.m.
					13. Water sample submitted: <input type="checkbox"/> Yes <input checked="" type="checkbox"/> No Date <input type="checkbox"/>
					14. Well head completion: <input type="checkbox"/> Pitless adapter <b>12</b> inches above grade
					15. Well grouted? <b>Yes</b> With: <input checked="" type="checkbox"/> Neat cement <input type="checkbox"/> Bentonite <input type="checkbox"/> Concrete Depth: From <b>0</b> ft. to <b>10</b> ft.
					16. Nearest source of possible contamination: <b>FIELD</b> ft. <input type="checkbox"/> Direction <input type="checkbox"/> Type <input type="checkbox"/> Well disinfected upon completion? <input type="checkbox"/> Yes <input checked="" type="checkbox"/> No
					17. Pump: <input checked="" type="checkbox"/> Not installed Manufacturer's name <input type="checkbox"/> Model number <input type="checkbox"/> HP <input type="checkbox"/> Volts <input type="checkbox"/> Length of drop pipe <input type="checkbox"/> ft. capacity <input type="checkbox"/> g.p.m. Type: <input type="checkbox"/> Submersible <input type="checkbox"/> Turbine <input type="checkbox"/> Jet <input type="checkbox"/> Reciprocating <input type="checkbox"/> Centrifugal <input type="checkbox"/> Other
(Use a second sheet if needed)					
18. Elevation:  Topography: <input type="checkbox"/> Hill <input type="checkbox"/> Slope <input type="checkbox"/> Upland <input type="checkbox"/> Valley	19. Remarks:		20. Water well contractor's certification: This well was drilled under my jurisdiction and this report is true to the best of my knowledge and belief. <b>Clarke Well &amp; Eq., Inc. 185</b> Business name <b>Great Bend, KS 67530</b> License No. <b>1-19-79</b> Address <b>D.W. Clarke</b> Date <b>10-12-78</b> Signed <b>D.W. Clarke</b> Authorized representative		

Forward the white, blue and pink copies to the Department of Health and Environment

Form WWC-5