

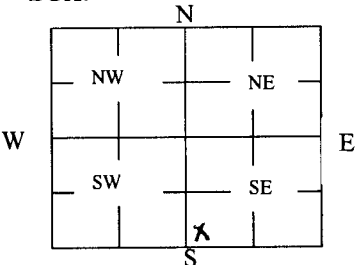
WATER WELL PLUGGING RECORD Form WWC-5P

KSA 82a-1212

ID NO.

20130646

1 LOCATION OF WATER WELL: County: Pawnee	Fraction 1/4 SW 1/4 SW 1/4 SE 1/4	Section Number 34	Township Number T 21 S	Range Number 16 ☐ E ☒ W
Street/Rural Address of Well Location; if unknown, distance & direction from nearest town or intersection: If at owner's address, check here ☐ 1E of Larned, KS		Global Positioning Systems (GPS) information: Latitude: _____ (in decimal degrees) Longitude: _____ (in decimal degrees) Elevation: _____ Datum: ☐ WGS84, ☐ NAD83, ☐ NAD27 Collection Method: ☐ GPS unit (Make/Model: _____) ☐ Digital Map/Photo, ☐ Topographic Map, ☐ Land Survey Est. Accuracy: ☐ < 3 m, ☐ 3-5 m, ☐ 5-15 m, ☐ > 15 m		
2 WATER WELL OWNER: L & S Properties RR#, St. Address, Box #: 4508 Quial Creek Rd. City, State ZIP Code: Great Bend, KS 67530				

3 MARK WELL'S LOCATION WITH AN "X" IN SECTION BOX: 	4 DEPTH OF WELL 51 ft. WELL'S STATIC WATER LEVEL 17 ft WELL WAS USED AS: <table border="0"> <tr> <td>☐ Domestic</td> <td>☐ Public Water Supply</td> <td>☐ Dewatering</td> </tr> <tr> <td>☐ Irrigation</td> <td>☒ Oil Field Water Supply</td> <td>☐ Monitoring</td> </tr> <tr> <td>☐ Feedlot</td> <td>☐ Domestic (Lawn & Garden)</td> <td>☐ Injection Well</td> </tr> <tr> <td>☐ Industrial</td> <td>☐ Air Conditioning</td> <td>☐ Other _____</td> </tr>

5 TYPE OF BLANK CASING USED:

☐ Steel	☐ RMP (SR)	☐ Wrought	☐ Fiberglass	☐ Other (Specify below) _____
☒ PVC	☐ ABS	☐ Asbestos-Cement	☐ Concrete Tile	

Blank casing diameter 5 in. Was casing pulled? Yes ☐ No ☒ If yes, how much _____
Casing height above or below land surface 3 ft. below in.

6 GROUT PLUG MATERIAL: ☐ Neat cement ☐ Cement grout ☒ Bentonite ☐ Other _____

Grout Plug Intervals: From 3 ft. to 23 ft., From _____ ft. to _____ ft., From _____ to _____ ft.

What is the nearest source of possible contamination:

☐ Septic tank	☐ Seepage pit	☐ Fuel Storage	☐ Other (specify below) _____
☐ Sewer lines	☐ Pit privy	☐ Fertilizer storage	
☐ Watertight sewer lines	☐ Sewage lagoon	☐ Insecticide storage	
☐ Lateral lines	☐ Feedyard	☐ Abandoned water well	Direction from well? East
☐ Cess pool	☐ Livestock pens	☒ Oil well/Gas well	How many feet? 115

FROM	TO	PLUGGING MATERIALS	FROM	TO	PLUGGING MATERIALS
51	23	gravel			
23	3	bentonite			Musselman 5-34
3	0	top soil			
					Sterling Drilling Company
					P O Box 1006
					Pratt, KS 67124

7 CONTRACTOR'S OR LANDOWNER'S CERTIFICATION: This water well was plugged under my jurisdiction and was completed on (mo/day/year) 11/12/13 and this record is true to the best of my knowledge and belief. Kansas Water Well Contractor's License No. 186. This Water Well Record was completed on (mo/day/year) 11/18/13 under the business name of Kelly's Water Well Service, Inc. by (signature) *Kathryn L. Ward*

INSTRUCTIONS: Use typewriter or ballpoint pen. Please press firmly and print clearly. Please fill in blanks, underline or circle the correct answers. Send one copy to Kansas Department of Health and Environment, Bureau of Water, Geology Section, 1000 SW Jackson St., Ste. 420, Topeka, Kansas 66612-1367. Telephone: 785/296-5524. Send one to Water Well Owner and retain one for your records. Visit us at <http://www.kdheks.gov/waterwell/index.html>.