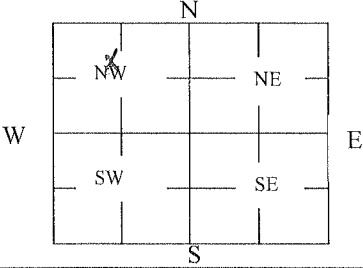


WATER WELL PLUGGING RECORD Form WWC-5P

KSA 82a-1212

ID NO.

20141086

1 LOCATION OF WATER WELL: County: Pawnee Street/Rural Address of Well Location; if unknown, distance & direction from nearest town or intersection: If at owner's address, check here ☐ 2 1/4 E of Larned, KS	Fraction 1/4 SE 1/4 NW 1/4 NW 1/4	Section Number 36	Township Number T 21 S	Range Number 16 ☐ E ☒ W	
2 WATER WELL OWNER: WFY Holding Company RR#, St. Address, Box #: P O Box 1506 City, State ZIP Code: Great Bend, KS 67530		Global Positioning Systems (GPS) information: Latitude: _____ (in decimal degrees) Longitude: _____ (in decimal degrees) Elevation: _____ Datum: ☐ WGS84, ☐ NAD83, ☐ NAD27 Collection Method: ☐ GPS unit (Make/Model: _____) ☐ Digital Map/Photo, ☐ Topographic Map, ☐ Land Survey Est. Accuracy: ☐ < 3 m, ☐ 3-5 m, ☐ 5-15 m, ☐ > 15 m	
3 MARK WELL'S LOCATION WITH AN "X" IN SECTION BOX: 	4 DEPTH OF WELL 49 ft. WELL'S STATIC WATER LEVEL 15 ft WELL WAS USED AS: <table style="width:100%;"><tr><td>☐ Domestic</td><td>☐ Public Water Supply</td><td>☐ Dewatering</td></tr><tr><td>☐ Irrigation</td><td>☒ Oil Field Water Supply</td><td>☐ Monitoring</td></tr><tr><td>☐ Feedlot</td><td>☐ Domestic (Lawn & Garden)</td><td>☐ Injection Well</td></tr><tr><td>☐ Industrial</td><td>☐ Air Conditioning</td><td>☐ Other _____</td></tr></table> Was a chemical/bacteriological sample submitted to Department? Yes ☐ No ☒				☐ Domestic	☐ Public Water Supply	☐ Dewatering	☐ Irrigation	☒ Oil Field Water Supply	☐ Monitoring	☐ Feedlot	☐ Domestic (Lawn & Garden)	☐ Injection Well	☐ Industrial	☐ Air Conditioning	☐ Other _____																														
☐ Domestic	☐ Public Water Supply	☐ Dewatering	
☐ Irrigation	☒ Oil Field Water Supply	☐ Monitoring	
☐ Feedlot	☐ Domestic (Lawn & Garden)	☐ Injection Well	
☐ Industrial	☐ Air Conditioning	☐ Other _____	
5 TYPE OF BLANK CASING USED: <table style="width:100%;"><tr><td>☐ Steel</td><td>☐ RMP (SR)</td><td>☐ Wrought</td><td>☐ Fiberglass</td><td>☐ Other (Specify below) _____</td></tr><tr><td>☒ PVC</td><td>☐ ABS</td><td>☐ Asbestos-Cement</td><td>☐ Concrete Tile</td><td></td></tr></table> Blank casing diameter 5 in. Was casing pulled? Yes ☐ No ☒ If yes, how much _____ Casing height above or below land surface 3ft below in.					☐ Steel	☐ RMP (SR)	☐ Wrought	☐ Fiberglass	☐ Other (Specify below) _____	☒ PVC	☐ ABS	☐ Asbestos-Cement	☐ Concrete Tile																																	
☐ Steel	☐ RMP (SR)	☐ Wrought	☐ Fiberglass	☐ Other (Specify below) _____	
☒ PVC	☐ ABS	☐ Asbestos-Cement	☐ Concrete Tile	
6 GROUT PLUG MATERIAL: ☐ Neat cement ☐ Cement grout ☒ Bentonite ☐ Other _____ Grout Plug Intervals: From 3 ft. to 20 ft. , From _____ ft. to _____ ft. , From _____ ft. to _____ ft. What is the nearest source of possible contamination: <table style="width:100%;"><tr><td>☐ Septic tank</td><td>☐ Seepage pit</td><td>☐ Fuel Storage</td><td rowspan="5">☐ Other (specify below) _____</td></tr><tr><td>☐ Sewer lines</td><td>☐ Pit privy</td><td>☐ Fertilizer storage</td></tr><tr><td>☐ Watertight sewer lines</td><td>☐ Sewage lagoon</td><td>☐ Insecticide storage</td></tr><tr><td>☐ Lateral lines</td><td>☐ Feedyard</td><td>☐ Abandoned water well</td></tr><tr><td>☐ Cess pool</td><td>☐ Livestock pens</td><td>☒ Oil well/Gas well</td></tr></table> Direction from well? East How many feet? 400					☐ Septic tank	☐ Seepage pit	☐ Fuel Storage	☐ Other (specify below) _____	☐ Sewer lines	☐ Pit privy	☐ Fertilizer storage	☐ Watertight sewer lines	☐ Sewage lagoon	☐ Insecticide storage	☐ Lateral lines	☐ Feedyard	☐ Abandoned water well	☐ Cess pool	☐ Livestock pens	☒ Oil well/Gas well																										
☐ Septic tank	☐ Seepage pit	☐ Fuel Storage	☐ Other (specify below) _____	
☐ Sewer lines	☐ Pit privy	☐ Fertilizer storage	
☐ Watertight sewer lines	☐ Sewage lagoon	☐ Insecticide storage	
☐ Lateral lines	☐ Feedyard	☐ Abandoned water well	
☐ Cess pool	☐ Livestock pens	☒ Oil well/Gas well	
<table border="1" style="width:100%; border-collapse: collapse;"><thead><tr><th>FROM</th><th>TO</th><th>PLUGGING MATERIALS</th><th>FROM</th><th>TO</th><th>PLUGGING MATERIALS</th></tr></thead><tbody><tr><td>49</td><td>20</td><td>gravel</td><td></td><td></td><td></td></tr><tr><td>20</td><td>3</td><td>bentonite</td><td></td><td></td><td>WFY 1-36</td></tr><tr><td>3</td><td>0</td><td>top soil</td><td></td><td></td><td></td></tr><tr><td></td><td></td><td></td><td></td><td></td><td>Sterling Drilling Company</td></tr><tr><td></td><td></td><td></td><td></td><td></td><td>P O Box 1006</td></tr><tr><td></td><td></td><td></td><td></td><td></td><td>Pratt, KS 67124</td></tr></tbody></table>					FROM	TO	PLUGGING MATERIALS	FROM	TO	PLUGGING MATERIALS	49	20	gravel				20	3	bentonite			WFY 1-36	3	0	top soil									Sterling Drilling Company						P O Box 1006						Pratt, KS 67124
FROM	TO	PLUGGING MATERIALS	FROM	TO	PLUGGING MATERIALS	
49	20	gravel	
20	3	bentonite			WFY 1-36	
3	0	top soil	
					Sterling Drilling Company	
					P O Box 1006	
					Pratt, KS 67124	
7 CONTRACTOR'S OR LANDOWNER'S CERTIFICATION: This water well was plugged under my jurisdiction and was completed on (mo/day/year) 01/26/15 and this record is true to the best of my knowledge and belief. Kansas Water Well Contractor's License No. 186. This Water Well Record was completed on (mo/day/year) 01/31/15 under the business name of Kelly's Water Well Service, Inc. by (signature) <i>Kathryn R. Pratt</i>	
INSTRUCTIONS: Use typewriter or ballpoint pen. Please press firmly and print clearly. Please fill in blanks, underline or circle the correct answers. Send one copy to Kansas Department of Health and Environment, Bureau of Water, Geology Section, 1000 SW Jackson St., Ste. 420, Topeka, Kansas 66612-1367. Telephone: 785/296-5524. Send one to Water Well Owner and retain one for your records. Visit us at http://www.kdheks.gov/waterwell/index.html .	