

OFFICE USE ONLY  
T  
R  
EW  
SEC.

1 LOCATION OF WATER WELL:	Fraction	Section Number	Township Number	Range Number

Distance and direction from nearest town or city street address of well if located within city?

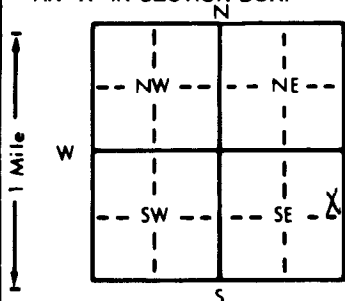
2 WATER WELL OWNER: 316 W 5th Larned KS 67550RR#, St. Address, Box # : Pera Reid

Board of Agriculture, Division of Water Resources

City, State, ZIP Code

Application Number:

3 LOCATE WELL'S LOCATION WITH AN "X" IN SECTION BOX:


WELL WATER TO BE USED AS: 5 Public water supply 8 Air conditioning 11 Injection well

1 Domestic 3 Feedlot 6 Oil field water supply 9 Dewatering 12 Other (Specify below)

2 Irrigation 4 Industrial 7 Lawn and garden only 10 Monitoring well

Was a chemical/bacteriological sample submitted to Department? Yes NA No NA; If yes, mo/day/yr sample was submittedWater Well Disinfected? Yes NA No NA

5 TYPE OF BLANK CASING USED:

1 Steel 3 RMP (SR)

2 PVC 4 ABS

5 Wrought iron

6 Asbestos-Cement

7 Fiberglass

8 Concrete tile

9 Other (specify below)


TYPE OF SCREEN OR PERFORATION MATERIAL:

1 Steel 3 Stainless steel

2 Brass 4 Galvanized steel

5 Fiberglass

6 Concrete tile

7 PVC

8 RMP (SR)

9 ABS

10 Asbestos-cement

11 Other (specify) NA

12 None used (open hole)

SCREEN OR PERFORATION OPENINGS ARE:

1 Continuous slot 3 Mill slot

2 Louvered shutter 4 Key punched

5 Gauzed wrapped

6 Wire wrapped

7 Torch cut

8 Saw cut

9 Drilled holes

10 Other (specify) NA

11 None (open hole)

SCREEN-PERFORATED INTERVALS: From NA ft. to NA ft., From NA ft. to NA ft.From NA ft. to NA ft., From NA ft. to NA ft.GRAVEL PACK INTERVALS: From NA ft. to NA ft., From NA ft. to NA ft.From NA ft. to NA ft., From NA ft. to NA ft.

6 GROUT MATERIAL:

1 Neat cement

2 Cement grout

3 Bentonite

4 Other

Grout Intervals: From 80 ft. to 0 ft., From 0 ft. to 0 ft., From 0 ft. to 0 ft.

What is the nearest source of possible contamination:

1 Septic tank

4 Lateral lines

7 Pit privy

10 Livestock pens

11 Fuel storage

12 Fertilizer storage

13 Insecticide storage

14 Abandoned water well

15 Oil well/Gas well

16 Other (specify below)

NONE

2 Sewer lines

5 Cess pool

8 Sewage lagoon

9 Feedyard

3 Watertight sewer lines

6 Seepage pit

Direction from well?

How many feet?

FROM	TO	LITHOLOGIC LOG	FROM	TO	PLUGGING INTERVALS
		Old House Well plugged with Bentonite			From Bottom To Top of well
			80	0	BENTONITE

7 CONTRACTOR'S OR LANDOWNER'S CERTIFICATION: This water well was (1) constructed, (2) reconstructed, or (3) plugged under my jurisdiction and was completed on (mo/day/year) 6-5-95 and this record is true to the best of my knowledge and belief. 