


1	LOCATION OF WATER WELL: County: Pawnee	Fraction SE ¼ SE ¼ SW ¼	Section Number 1	Township Number T 21 S	Range Number R 18W E/W
---	---	----------------------------	---------------------	---------------------------	---------------------------

Distance and direction from nearest town or city street address of well if located within city?
5 N, 3½ E of Sanford, Kansas

2	WATER WELL OWNER:	Roger Gore	
	RR#, St. Address, Box # :	923 Topeka	Board of Agriculture, Division of Water Resources
	City, State, ZIP Code :	Larned, Kansas 67550	Application Number:

3	LOCATE WELL'S LOCATION WITH AN "X" IN SECTION BOX:	4	DEPTH OF COMPLETED WELL..... 100 ft. ELEVATION: Unknown
			Depth(s) Groundwater Encountered 1. 42 ft. 2. ft. 3. ft.

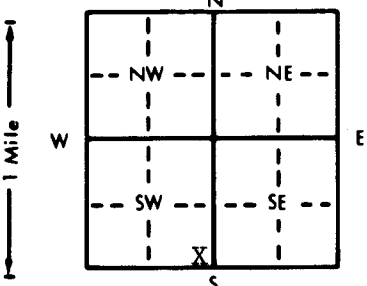

4 DEPTH OF COMPLETED WELL: 100 ft. ELEVATION: Unknown
Depth(s) Groundwater Encountered 1 42 ft. 2. ft. 3. ft.

WELL'S STATIC WATER LEVEL 42± ft. below land surface measured on mo/day/yr 7/12/93

Pump test data: Well water was ft. after hours pumping gpm

Est. Yield gpm: Well water was ft. after hours pumping gpm

Bore Hole Diameter 8 in. to 100 ft. and in. to ft.

WELL WATER TO BE USED AS: 5 Public water supply 8 Air conditioning 11 Injection well

1 Domestic	3 Feedlot	6 Oil field water supply	9 Dewatering	12 Other (Specify below)
------------	-----------	--------------------------	--------------	--------------------------

Was a chemical/bacteriological sample submitted to Department? Yes..... No.....; If yes, mo/day/yr sample was sub

Water Well Disinfected? Yes ~~NO~~

5 TYPE OF BLANK CASING USED: 5 Wrought iron 8 Concrete tile CASING JOINTS: Glued Clamped

1 Steel	3 RMP (SR)	6 Asbestos-Cement	9 Other (specify below)	Welded
2 PVC	4 ABS	7 Fiberglass		Threaded

Blank casing diameter 5 in. to 80 ft., Dia in. to ft., Dia in. to ft.

Casing height above land surface 12 in., weight 2.8 lbs./ft. Wall thickness or gauge No. Sch. 40

TYPE OF SCREEN OR PERFORATION MATERIAL:

1 Steel	3 Stainless steel	5 Fiberglass	7 <u>PVC</u>	10 Asbestos-cement
			8 RMP (SR)	11 Other (specify)

1 Steel	3 Stainless steel	5 Fiberglass	7 Tuff (SM)	9 Other (specify) _____
2 Brass	4 Galvanized steel	6 Concrete tile	8 ABS	10 None used (open hole)

SCREEN OR PERFORATION OPENINGS ARE: 5 Gauzed wrapped 8 Saw cut 11 None (open hole)

1 Continuous slot	3 Mill slot	6 Wire wrapped	9 Drilled holes
2 Louvered shutter	4 Key punched	7 Torch cut	10 Other (specify) _____

SCREEN-PERFORATED INTERVALS: From 80 ft. to 100 ft. From . ft. to . ft.

From ft. to ft. From ft. to ft.

GRAVEL PACK INTERVALS: From ft. to ft., From ft. to ft.
From ft. to ft. From ft. to ft.

6 GROUT MATERIAL: 1 Neat cement 2 Cement grout 3 Bentonite 4 Other

Grout Intervals: From 0 ft. to 20 ft., From _____ ft. to _____ ft., From _____ ft. to _____ ft.

What is the nearest source of possible contamination:

1 Sptic tank	4 Lateral lines	7 Pit privy	10 Livestock pens	14 Abandoned water well
2 Septic tank	5 Lateral lines	8 Pit privy	11 Fuel storage	15 Oil well/Gas well

2 Sewer lines	5 Cess pool	8 Sewage lagoon	12 Fertilizer storage	16 Other (specify below)
---------------	-------------	-----------------	-----------------------	--------------------------

3 Watertight sewer lines	6 Seepage pit	9 Feedyard	13 Insecticide storage	150
--------------------------	---------------	------------	------------------------	-------	-----

Direction from well?		South		How many feet?		150	
FROM	TO	LITHOLOGIC LOG		FROM	TO	PLUGGING INTERVALS	

0	78	Clay			
---	----	------	--	--	--

78	100	Sand rock			

[illegible][illegible]

--	--	--	--	--	--

[illegible][illegible][illegible][illegible][illegible]

7. CONTRACTOR'S OR LANDOWNER'S CERTIFICATION: This water well was (1) constructed, (2) reconstructed, or (3) plugged under my jurisdiction and was

7. CONTRACTORS OR LANDOWNER'S CERTIFICATION: This water well was (1) constructed, (2) reconstructed, or (3) plugged under my jurisdiction and was completed on (mo/day/year) 7/12/93..... and this record is true to the best of my knowledge and belief. Kansas

Water Well Contractor's License No. 186 This Water Well Record was completed on (mo/day/yr) 8/5/93

under the business name of Kelly's Water Well Service, Inc. by (signature) Alvin Good

INSTRUCTIONS: Use typewriter or ball point pen. PLEASE PRESS HARD and PRINT clearly. Please fill in blanks, underline or circle the correct answers. Send top three copies to Kansas Department of Health and Environment, Bureau of Water, Topeka, Kansas 66620-0001. Telephone: 913-296-5545. Send one to WATER WELL OWNER and retain one for your records.
