


1 LOCATION OF WATER WELL: Fraction Section Number Township Number Range Number
 County: Pawnee SW 1/4 SW 1/4 NW 1/4 36 21 19 E/W

Distance and direction from nearest town or city street address of well if located within city?

2 WATER WELL OWNER: Sawmill Creek Farm LLC
 RR #, St. Address, Box #: P.O. Box 361 Board of Agriculture, Division of Water Resources
 City, State, ZIP Code : Quinter KS 67752 Application Number:

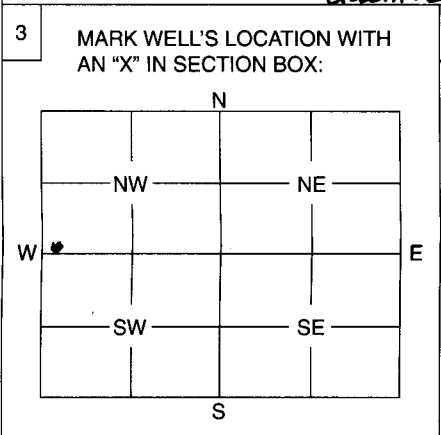

4 DEPTH OF WELL 101 ft.
 WELL'S STATIC WATER LEVEL 37 ft.
 WELL WAS USED AS:
 1 Domestic 5 Public Water Supply 9 Dewatering
~~2 Irrigation~~ 6 Oil Field Water Supply 10 Monitoring Well
 3 Feedlot 7 Domestic (Lawn & Garden) 11 Injection Well
 4 Industrial 8 Air Conditioning 12 Other

Was a chemical / bacteriological sample submitted to Department? Yes No
 If yes, mo/day/yr sample was submitted

Water Well Disinfected: Yes No

5 TYPE OF BLANK CASING USED:
 1 Steel 3 RMP (SR) 5 Wrought 7 Fiberglass 9 Other (Specify below)
 2 PVC 4 ABS 6 Asbestos-Cement 8 Concrete Tile

Blank casing diameter 17 in. Was casing pulled? Yes No
 Casing height above or below land surface 4' in. If yes, how much

6 GROUT PLUG MATERIAL: 1 Neat cement 2 Cement grout 3 Bentonite 4 Other

Grout Plug Intervals: From ft. to ft., From ft. to ft., From to ft.

What is the nearest source of possible contamination:
 1 Septic tank 6 Seepage pit 11 Fuel storage 16 Other (specify below)
 2 Sewer lines 7 Pit privy 12 Fertilizer storage Irrigation Well
 3 Watertight sewer lines 8 Sewage lagoon 13 Insecticide storage 1/2 mile away
 4 Lateral lines 9 Feedyard 14 Abandoned water well
 5 Cess pool 10 Livestock pens 15 Oil well/Gas well

Direction from well? How many feet?

FROM	TO	PLUGGING MATERIALS
101	41	Sand
41	38	Bentonite
38	7	Clay soil
7	4	Bentonite
4	Surface	Dirt

7 CONTRACTOR'S OF LANDOWNER'S CERTIFICATION: This water well was plugged under my jurisdiction and was completed on (mo/day/year) June 23, 2005 and this record is true to the best of my knowledge and belief. Kansas Water Well Contractor's License No. Owner This Water Well Record was completed on (mo/day/year) June 24, 2005 under the business name of Sawmill Creek Farm LLC by (signature) Marvin Janje P.O.A.

INSTRUCTIONS: Use typewriter or ball point pen. Please press firmly and print clearly. Please fill in blanks, underline or circle the correct answers. Send top three copies to Kansas Department of Health and Environment, Bureau of Water, Geology Section, 1000 SW Jackson St., Ste. 420, Topeka, Kansas 66612-1367. Telephone: 785/296-5522. Send one to Water Well Owner and retain one for your records.