


1 LOCATION OF WATER WELL:	Fraction	Section Number	Township Number	Range Number
County: Pawnee	SE 1/4 SE 1/4 SE 1/4	28	21	19 W

Distance and direction from nearest town or city street address of well if located within city?

2 WATER WELL OWNER:	Don Shank	"The Store" Rozel KS
RR#, St. Address, Box #	PO Box 27	Board of Agriculture, Division of Water Resources
City, State, ZIP Code	Burdett, KS 67523	Application Number:

3 MARK WELL'S LOCATION WITH AN "X" IN SECTION BOX:

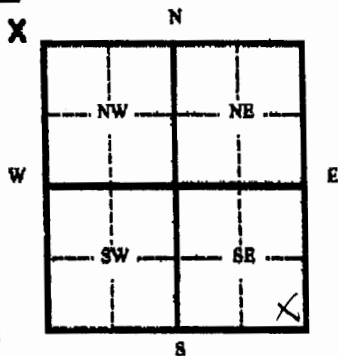

4 DEPTH OF WELL 50.95 ft.

WELL'S STATIC WATER LEVEL _____ ft.

WELL WAS USED AS:

- | | | |
|--------------|------------------------------|--------------------|
| 1 Domestic | 5 Public Water Supply | 9 Dewatering |
| 2 Irrigation | 6 Oil Field Water Supply | 10 Monitoring Well |
| 3 Feedlot | 7 Lawn and Garden (domestic) | 11 Injection Well |
| 4 Industrial | 8 Air Conditioning | 12 Other _____ |

Was a chemical/bacteriological sample submitted to Department? Yes _____ No _____

If yes, mo/day/yr sample was submitted _____

Water Well Disinfected: Yes _____ No _____

5 TYPE OF BLANK CASING USED:

- | | | | | |
|---------|------------|-------------------|-----------------|-------------------------|
| 1 Steel | 3 RMP (SR) | 5 Wrought | 7 Fiberglass | 9 Other (specify below) |
| 2 PVC | 4 ABC | 6 Asbestos-Cement | 8 Concrete Tile | |

Blank casing diameter _____ in. Was casing pulled? Yes _____ No _____ If yes, how much _____

Casing height above or below land surface _____ in.

6 GROUT PLUG MATERIAL:	1 Neat cement	2 Cement grout	3 Bentonite	4 Other _____
Grout Plug Interval	From _____ ft. to _____ ft.	From _____ ft. to _____ ft.	From _____ ft. to _____ ft.	

What is the nearest source of possible contamination:

- | | | | |
|--------------------------|-------------------|-------------------------|--------------------------|
| 1 Septic tank | 6 Seepage pit | 11 Fuel storage | 18 Other (specify below) |
| 2 Sewer lines | 7 Pit privy | 12 Fertilizer storage | UST Site |
| 3 Watertight sewer lines | 8 Sewage lagoon | 13 Insecticide storage | |
| 4 Lateral lines | 9 Feedyard | 14 Abandoned water well | |
| 5 Cess Pool | 10 Livestock pens | 15 Oil well/ Gas well | |

Direction from well? _____ How many feet? _____

FROM	TO	CODE	PLUGGING MATERIALS
0	3		Native pack
3	60.95		Bentonite

7 CONTRACTOR'S OR LANDOWNER'S CERTIFICATION: This water well was plugged under my jurisdiction and was completed on (mo/day/yr) 8/22/06 - 8/24/06 and this record is true to the best of my knowledge and belief. Kansas Water Well Contractor's License No. _____ This Water Well Record was completed on (mo/day/yr) _____ under the business name of Bluestem Environmental Engineering by (signature) Nick H.

INSTRUCTIONS: Please fill in blanks and circle the correct answers. Send three copies to Kansas Department of Health and Environment, Bureau of Water, 1000 S W Jackson St., Ste. 420, Topeka, Kansas 66620-0001. Telephone: 85-298-3585. Send one to Water Well Owner and retain one for your records.