


1 LOCATION OF WATER WELL:	Fraction	Section Number	Township Number	Range Number
County: McPherson	NE ¼ NW ¼ NE ¼	27	T 21 S	R 2 E 7

Distance and direction from nearest town or city street address of well if located within city?

West Side of Moundridge Elementary School Property

2	WATER WELL OWNER:	Mid-Kansas Co-op	01968024 MW-11 Deep
	RR#, St. Address, Box # :	307 West Cole	Board of Agriculture, Division of Water Resources
	City, State, ZIP Code :	Moundridge, Kansas	Application Number:

3	LOCATE WELL'S LOCATION WITH AN "X" IN SECTION BOX:	4	DEPTH OF COMPLETED WELL	54	ft.	ELEVATION:	Approx Surface 1485
---	--	---	-------------------------	----	-----	------------	---------------------

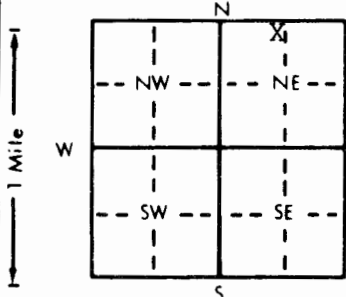

4 DEPTH OF COMPLETED WELL: 54 ft. ELEVATION: Approx Surface 1485
Depth(s) Groundwater Encountered 1. ft. 2. ft. 3. ft.
WELL'S STATIC WATER LEVEL 18 ft. below land surface measured on mo/day/yr 12/18/96
Pump test data: Well water was ft. after hours pumping gpm
Est. Yield N/A gpm: Well water was ft. after hours pumping gpm
Bore Hole Diameter 8.25 in. to 54 ft., and in. to ft.
WELL WATER TO BE USED AS:
1 Domestic 3 Feedlot 6 Oil field water supply 8 Air conditioning 11 Injection well
2 Irrigation 4 Industrial 7 Lawn and garden only 9 Dewatering 12 Other (Specify below)
10 Monitoring well
Was a chemical/bacteriological sample submitted to Department? Yes No X; If yes, mo/day/yr sample was submitted
Water Well Disinfected? Yes No X

5 TYPE OF BLANK CASING USED:

1 Steel	3 RMP (SR)	5 Wrought iron	8 Concrete tile	CASING JOINTS: Glued	Clamped
2 PVC	4 ABS	6 Asbestos-Cement	9 Other (specify below)	Welded	
		7 Fiberglass		Threaded	X

Blank casing diameter 2 in. to 44 ft., Dia. in. to ft., Dia. in. to ft.

Casing height above land surface -2 in., weight lbs./ft. Wall thickness or gauge No. Schedule 40

TYPE OF SCREEN OR PERFORATION MATERIAL:

1 Steel	3 Stainless steel	5 Fiberglass	7 PVC	10 Asbestos-cement
2 Brass	4 Galvanized steel	6 Concrete tile	8 RMP (SR)	11 Other (specify)
			9 ABS	12 None used (open hole)

SCREEN OR PERFORATION OPENINGS ARE:

1 Continuous slot	3 Mill slot	5 Gauzed wrapped	8 Saw cut	11 None (open hole)
2 Louvered shutter	4 Key punched	6 Wire wrapped	9 Drilled holes	
		7 Torch cut	10 Other (specify)	

SCREEN-PERFORATED INTERVALS: From 44 ft. to 54 ft., From ft. to ft.

GRAVEL PACK INTERVALS: From 42 ft. to 54 ft., From ft. to ft.

6 GROUT MATERIAL: ① Neat cement 2 Cement grout ③ Bentonite 4 Other
Grout Intervals: From 0 ft. to 40 ft., From 40 ft. to 42 ft., From ft. to ft.
What is the nearest source of possible contamination:
1 Septic tank 4 Lateral lines 7 Pit privy 10 Livestock pens 14 Abandoned water well
2 Sewer lines 5 Cess pool 8 Sewage lagoon 11 Fuel storage 15 Oil well/Gas well
3 Watertight sewer lines 6 Seepage pit 9 Feedyard 12 Fertilizer storage 16 Other (specify below)
13 Insecticide storage
Direction from well? How many feet?

[illegible]

7 CONTRACTOR'S OR LANDOWNER'S CERTIFICATION: This water well was (1) constructed, (2) reconstructed, or (3) plugged under my jurisdiction and was completed on (mo/day/year) 12/14/96 and this record is true to the best of my knowledge and belief. Kansas Water Well Contractor's License No. 416 This Water Well Record was completed on (mo/day/yr) 1-8-97 under the business name of Terracon Consultants, Inc. by (signature) [Signature]