WATER WELL RECORD Form WWC-5 KSA 82a-1212 ID No. _____

1 LOCATION OF WATER WELL: County: McPHERSON | Fraction: NE ¼ SE ¼ NW ¼ | Section Number: 26 | Township Number: T 21 S | Range Number: R 2 E/W

Distance and direction from nearest town or city street address of well if located within city?
EASTERN EDGE OF MOUNDRIDGE.

2 WATER WELL OWNER: ROGER STUCKY
RR#, St. Address, Box # : P.O BOX 263
City, State, ZIP Code : MOUNDRIDGE, KS. 67107
Board of Agriculture, Division of Water Resources Application Number: —

3 LOCATE WELL'S LOCATION WITH AN "X" IN SECTION BOX:

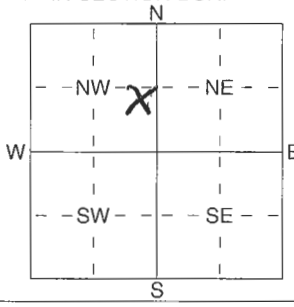

4 DEPTH OF COMPLETED WELL 110 ft. ELEVATION: —
Depth(s) Groundwater Encountered 1 25 ft. 2 110 ft. 3 — ft.
WELL'S STATIC WATER LEVEL 30 ft. below land surface measured on mo/day/yr 1/31/05
Pump test data: Well water was — ft. after — hours pumping — gpm
Est. Yield 70 gpm: Well water was — ft. after — hours pumping — gpm
WELL WATER TO BE USED AS: 1 Domestic 2 Irrigation 3 Feedlot 4 Industrial 5 Public water supply 6 Oil field water supply 7 Domestic (lawn & garden) 8 Air conditioning 9 Dewatering 10 Monitoring well 11 Injection well 12 Other (Specify below)

Was a chemical/bacteriological sample submitted to Department? Yes ..... No X ; If yes, mo/day/yrs sample was submitted
Water Well Disinfected? Yes X No

5 TYPE OF BLANK CASING USED: 1 Steel 2 PVC 3 RMP (SR) 4 ABS 5 Wrought iron 6 Asbestos-Cement 7 Fiberglass 8 Concrete tile 9 Other (specify below)
CASING JOINTS: Glued X Clamped — Welded — Threaded —
Blank casing diameter 5 in. to 70 ft., Dia — in. to — ft., Dia — in. to — ft.
Casing height above land surface 24 in., weight — lbs./ft. Wall thickness or guage No. SDR21

TYPE OF SCREEN OR PERFORATION MATERIAL: 1 Steel 2 Brass 3 Stainless Steel 4 Galvanized Steel 5 Fiberglass 6 Concrete tile 7 PVC 8 RMP (SR) 9 ABS 10 Asbestos-Cement 11 Other (Specify) 12 None used (open hole)

SCREEN OR PERFORATION OPENINGS ARE: 1 Continuous slot 2 Louvered shutter 3 Mill slot 4 Key punched 5 Guazed wrapped 6 Wire wrapped 7 Torch cut 8 Saw cut 9 Drilled holes 10 Other (specify) ..... 11 None (open hole)

SCREEN-PERFORATED INTERVALS: From 90 ft. to 110 ft., From — ft. to — ft.
From — ft. to — ft., From — ft. to — ft.
GRAVEL PACK INTERVALS: From 24 ft. to 32 ft., From 50 ft. to 110 ft.
From — ft. to — ft., From — ft. to — ft.

6 GROUT MATERIAL: 1 Neat cement 2 Cement grout 3 Bentonite 4 Other .....
Grout Intervals: From 4 ft. to 24 ft., From 32 ft. to 50 ft., From — ft. to — ft.

What is the nearest source of possible contamination:
1 Septic tank 2 Sewer lines 3 Watertight sewer lines 4 Lateral lines 5 Cess pool 6 Seepage pit 7 Pit privy 8 Sewage lagoon 9 Feedyard 10 Livestock pens 11 Fuel storage 12 Fertilizer storage 13 Insecticide storage 14 Abandoned water well 15 Oil well/Gas well 16 Other (specify below) HOUSE
Direction from well? NORTH How many feet? 80

FROM	TO	LITHOLOGIC LOG	FROM	TO	PLUGGING INTERVALS
0	20	CLAY, BROWN TO GRAY			
20	27	SAND, FINE TO MED., H2O			
27	110	SHALE, GRAY, COBBLES AT 110.			BOREHOLE DIAMETER 14.5" TO 32. 9" TO 110. SURFACE CASING (10") WAS SET AND PULLED.

7 CONTRACTOR'S OR LANDOWNER'S CERTIFICATION: This water well was (1) constructed, (2) reconstructed, or (3) plugged under my jurisdiction and was completed on (mo/day/year) 1/31/05 and this record is true to the best of my knowledge and belief. Kansas Water Well Contractor's Licence No 585 This Water Well Record was completed on (mo/day/yr) 2/9/05 under the business name of ASSOCIATED ENVIRONMENTAL INC by (signature) [signature]

INSTRUCTIONS: Use typewriter or ball point pen. PLEASE PRESS FIRMLY and PRINT clearly. Please fill in blanks, underline or circle the correct answers. Send top three copies to Kansas Department of Health and Environment, Bureau of Water, Geology Section, 1000 SW Jackson St., Suite 420, Topeka, Kansas 66612-1367. Telephone 785-296-5522. Send one to WATER WELL OWNER and retain one for your records. Fee of $5.00 for each constructed well.