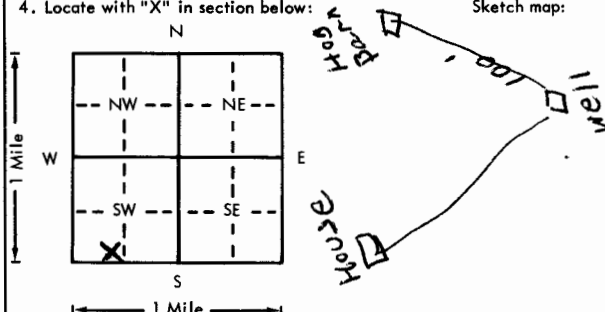


USE TYPEWRITER OR BALL
POINT PEN-PRESS FIRMLY,
PRINT CLEARLY.

WATER WELL RECORD
KSA 82a-1201-1215

Kansas Department of Health and
Environment-Division of Environment
(Water well Contractors)
Topeka, Kansas 66620

1. Location of well: <u>McPherson</u>		County: <u>McPherson</u>	Fraction: <u>SE 1/4 SW 1/4 SW 1/4</u>	Section number: <u>1</u>	Township number: <u>T 21 S R 2 E</u>	Range number: <u>2</u>
2. Distance and direction from nearest town or city: <u>7 1/2 W</u>			3. Owner of well: <u>David Yost</u>			
Street address of well location if in city: <u>Goessel</u>			R.R. or street: <u>RR2</u>			
			City, state, zip code: <u>Moundridge, KS 67107</u>			
4. Locate with "X" in section below:		Sketch map:		6. Bore hole dia. <u>5 1/2</u> in. Completion date <u>12-12-75</u>		
				Well depth <u>55</u> ft.		
5. Type and color of material		From		To		7. Cable tool <input checked="" type="checkbox"/> Rotary <input type="checkbox"/> Driven <input type="checkbox"/> Dug
<u>Top Soil - yellow clay</u>		<u>0</u>		<u>10</u>		<input type="checkbox"/> Hollow rod <input type="checkbox"/> Jetted <input type="checkbox"/> Bored <input type="checkbox"/> Reverse rotary
<u>fine Sand</u>		<u>10</u>		<u>40</u>		8. Use: <input type="checkbox"/> Domestic <input type="checkbox"/> Public supply <input type="checkbox"/> Industry
<u>Medium Sand</u>		<u>40</u>		<u>55</u>		<input type="checkbox"/> Irrigation <input type="checkbox"/> Air conditioning <input checked="" type="checkbox"/> Stock
<u>Blue Shale</u>		<u>55</u>				<input type="checkbox"/> Lawn <input type="checkbox"/> Oil field water <input type="checkbox"/> Other
						9. Casing: Material <u>PVC</u> Height: <u>5 1/2</u> in.
						Threaded <input type="checkbox"/> Welded <input type="checkbox"/> Surface <input type="checkbox"/> RMP <input type="checkbox"/> PVC <input checked="" type="checkbox"/> Weight <u>160</u> lbs./ft.
						Dia. <u>5</u> in. to <u>5 1/2</u> ft. depth Wall Thickness: inches or
						Dia. <u>5</u> in. to <u>5 1/2</u> ft. depth gage No. <u>025</u>
						10. Screens: Manufacturer's name <u>Pumpco Supply</u>
						Type <u>PVC</u> Dia. <u>5 1/2</u> in.
						Slot/gauze <u>40</u> Length <u>10</u>
						Set between <u>45</u> ft. and <u>55</u> ft.
						Gravel pack? <input checked="" type="checkbox"/> Size range of material <u>4</u>
						11. Static water level: <u>25</u> ft. below land surface Date <u>12-12-75</u>
						12. Pumping level below land surfaces:
						<u>25</u> ft. after <u>0</u> hrs. pumping <u>0</u> g.p.m.
						<u>25</u> ft. after <u>0</u> hrs. pumping <u>0</u> g.p.m.
						Estimated maximum yield <u>0</u> g.p.m.
						13. Water sample submitted: <u>0</u> mo./day/yr.
						<input type="checkbox"/> Yes <input type="checkbox"/> No Date <u>12-12-75</u>
						14. Well head completion: <u>well House</u>
						<input type="checkbox"/> Pitless adapter <u>12</u> inches above grade
						15. Well grouted? <input checked="" type="checkbox"/>
						With: <input type="checkbox"/> Neat cement <input type="checkbox"/> Bentonite <input checked="" type="checkbox"/> Concrete
						Depth: From <u>0</u> ft. to <u>10</u> ft.
						16. Nearest source of possible contamination: <u>Hog</u>
						ft. <u>100</u> Direction <u>West</u> Type <u>Barn</u>
						Well disinfected upon completion? <input type="checkbox"/> Yes <input type="checkbox"/> No
						17. Pump: <input checked="" type="checkbox"/> Not installed
						Manufacturer's name <u>Backhus Drilling</u>
						Model number <u>180</u> HP <u>1/2</u> Volts <u>115</u>
						Length of drop pipe <u>10</u> ft. capacity <u>0</u> g.p.m.
						Type: <input type="checkbox"/> Submersible <input type="checkbox"/> Turbine
						<input type="checkbox"/> Jet <input type="checkbox"/> Reciprocating
						<input type="checkbox"/> Centrifugal <input type="checkbox"/> Other
18. Elevation:		19. Remarks:		20. Water well contractor's certification:		
Topography: <input checked="" type="checkbox"/> Hill <input type="checkbox"/> Slope <input type="checkbox"/> Upland <input type="checkbox"/> Valley		<u>Concrete Slab + well</u> <u>House on well</u>		This well was drilled under my jurisdiction and this report is true to the best of my knowledge and belief.		
				Business name <u>Backhus Drilling</u> License No. <u>180</u>		
				Address <u>Tampa, KS</u>		
				Signed <u>Paul Backhus</u> Date <u>12-10-75</u>		
				Authorized representative		

Forward the white, blue and pink copies to the Department of Health and Environment

Form WWC-5