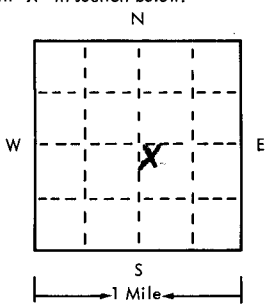


USE TYPEWRITER OR BALL
POINT PEN-PRESS FIRMLY,
PRINT CLEARLY.

WATER WELL RECORD
KSA 82a-1201-1215

T R EW sec 1/4 1/4 1/4 No.

Kansas State Dept. Of Health
(Water Well Contractors)
Forbes-Bldg. 740
Topeka, Kansas 66620

1 Location of well:		County Mcpherson	Township name NWNWSE	Section number 9	Town number 215	Range number R2W
Distance and direction from nearest town or city:		1 1/2 mi west of				
Street address of well location if in city:		Moundridge Ks 2 mi. Address:				
Locate with "X" in section below:		Sketch map:		4 Well depth: 100 ft. Date of completion 7-26-75 Well diameter 10 in.		
				5 <input type="checkbox"/> Cable tool <input checked="" type="checkbox"/> Rotary <input type="checkbox"/> Driven <input type="checkbox"/> Dug <input type="checkbox"/> Hollow rod <input type="checkbox"/> Jetted <input type="checkbox"/> Bored <input type="checkbox"/> Reverse rotary		
2		Type and color of material		From	To	6 Use: <input type="checkbox"/> Domestic <input type="checkbox"/> Public supply <input type="checkbox"/> Industry <input type="checkbox"/> Irrigation <input type="checkbox"/> Air conditioning <input type="checkbox"/> Commercial <input type="checkbox"/> Test well <input checked="" type="checkbox"/> Pond
		Black Topsoil		0	3	7 Casing: Material RMP Height: above below Threaded <input type="checkbox"/> Welded <input type="checkbox"/> Surface 12 in. Diam. 6 in. to 40 ft. depth Drive shoe? <input type="checkbox"/> Yes <input checked="" type="checkbox"/> No
		Gray clay		3	5	8 Screen: Manufacturer Sunflower Type RMP Dia. 6" Slot/gauze 3/16" Length 14' Set between ft. and ft. Fittings: Gravel pack <input checked="" type="checkbox"/> Yes <input type="checkbox"/> No Size range of material rd gravel
		light yellow clay with w/rock		5	9	9 Static water level: 6 ft. below land surface Date 7-26-75
		Fine sand		9	10	10 Pumping level below land surfaces: 40 ft. after 5 hrs. pumping 20 g.p.m. ft. after hrs. pumping g.p.m. Estimated maximum yield 33 g.p.m.
		Brown clay		10	15	11 Water sample submitted: <input type="checkbox"/> Yes <input checked="" type="checkbox"/> No Date
		Sand		15	25	12 Well head completion: <input type="checkbox"/> Pitless adapter <input checked="" type="checkbox"/> 12" inches above grade
		Blue + red shale		25	100	13 Well grouted? <input checked="" type="checkbox"/> Yes <input type="checkbox"/> No <input checked="" type="checkbox"/> Neat cement <input type="checkbox"/> Bentonite <input type="checkbox"/> Depth: From 0 ft. to 10 ft.
						14 Nearest source of possible contamination: ft. 10 Direction S.E. Type Pond Well disinfected upon completion? <input checked="" type="checkbox"/> Yes <input type="checkbox"/> No
						15 Pump: <input checked="" type="checkbox"/> Not installed Manufacturer's name Model number HP Volts Length of drop pipe ft. capacity g.p.m. Type: <input type="checkbox"/> Submersible <input type="checkbox"/> Turbine <input type="checkbox"/> Jet <input type="checkbox"/> Reciprocating <input type="checkbox"/> Centrifugal <input type="checkbox"/> Other
16 Remarks: elevation						17 Water well contractor's certification: This well was drilled under my jurisdiction and this report is true to the best of my knowledge and belief. Miller Water Well Serv Business name Hutchinson, Ks 137 License No. Address 400 Mill Date 8-3-75 Signed Authorized representative

Forward the white, blue and pink copies to the Kansas State Dept. Of Health.

Form WWC-5