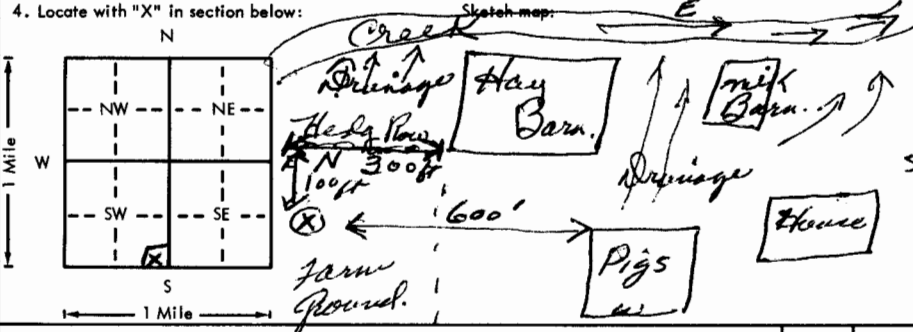


USE TYPEWRITER OR BALL
POINT PEN-PRESS FIRMLY,
PRINT CLEARLY.

WATER WELL RECORD
KSA 82a-1201-1215

Kansas Department of Health and
Environment-Division of Environment
(Water well Contractors)
Topeka, Kansas 66620

1. Location of well:	County <u>McPherson</u>	Fraction <u>SE 1/4 SE 1/4 SW 1/4</u>	Section number <u>10</u>	Township number <u>T 21 S</u>	Range number <u>R 2 E (W)</u>
2. Distance and direction from nearest town or city: <u>2 N - 3/4 W</u> Street address of well location if in city: <u>Moundridge, Kansas</u>	3. Owner of well: <u>Kenneth Schrag</u> R.R. or street: <u>RR 2</u> City, state, zip code: <u>Moundridge, Kan. 67107</u>				
4. Locate with "X" in section below: 			6. Bore hole dia. <u>8</u> in. Completion date <u>11-4-75</u> Well depth <u>42</u> ft.		
5. Type and color of material			7. <input checked="" type="checkbox"/> Cable tool <input checked="" type="checkbox"/> Rotary <input type="checkbox"/> Driven <input type="checkbox"/> Dug <input type="checkbox"/> Hollow rod <input type="checkbox"/> Jetted <input type="checkbox"/> Bored <input type="checkbox"/> Reverse rotary		
8. Use: <input checked="" type="checkbox"/> Domestic <input type="checkbox"/> Public supply <input type="checkbox"/> Industry <input type="checkbox"/> Irrigation <input type="checkbox"/> Air conditioning <input type="checkbox"/> Stock <input type="checkbox"/> Lawn <input type="checkbox"/> Oil field water <input type="checkbox"/> Other			9. Casing: Material <u>pvc</u> Height Above or below Threaded <input type="checkbox"/> Welded <input checked="" type="checkbox"/> Surface <u>24</u> in. RMP <input type="checkbox"/> PVC <input checked="" type="checkbox"/> Weight <u>7.5</u> lbs./ft. Dia. <u>5</u> in. to <u>44</u> ft. depth Wall Thickness: inches or Dia. <u>5</u> in. to <u>44</u> ft. depth gage No. <u>44"</u>		
10. Screen: Manufacturer's name <u>Jet Screen</u> <u>Wellscreen Co.</u> Type <u>PVC</u> Dia. <u>5"</u> Slot/gauze <u>1/16</u> Length <u>20'</u> Set between <u>42</u> ft. and <u>22</u> ft. Gravel pack? <u>44-42</u> ft. and <u>44-42</u> ft.			11. Static water level: <u>11</u> ft. below land surface Date <u>11-4-75</u> mo./day/yr.		
12. Pumping level below land surfaces: <u>28</u> ft. after <u>2</u> hrs. pumping <u>7</u> g.p.m. ft. after <u> </u> hrs. pumping <u> </u> g.p.m. Estimated maximum yield <u>25</u> g.p.m.			13. Water sample submitted: <u>X</u> Yes <u> </u> No Date <u>11-7-75</u> mo./day/yr.		
14. Well head completion: <u>Pump House</u> <u> </u> Pitless adapter <u>18"</u> inches above grade			15. Well grouted? <u>Yes</u> With: <input checked="" type="checkbox"/> Neat cement <input type="checkbox"/> Bentonite <input type="checkbox"/> Concrete Depth: From <u>0</u> ft. to <u>11</u> ft.		
16. Nearest source of possible contamination: <u>Pigs</u> ft. <u>600</u> Direction <u>S</u> Type <u>Pigs</u> Well disinfected upon completion? <input checked="" type="checkbox"/> Yes <input type="checkbox"/> No			17. Pump: <input checked="" type="checkbox"/> Not installed Manufacturer's name <u> </u> HP <u> </u> Volts <u> </u> Model number <u> </u> Length of drop pipe <u> </u> ft. capacity <u> </u> g.p.m. Type: <input type="checkbox"/> Submersible <input type="checkbox"/> Turbine <input type="checkbox"/> Jet <input type="checkbox"/> Reciprocating <input type="checkbox"/> Centrifugal <input type="checkbox"/> Other		
18. Elevation:			19. Remarks: <u>Mr. Schrag is pouring a slab for pump house.</u>		
20. Water well contractor's certification: This well was drilled under my jurisdiction and this report is true to the best of my knowledge and belief. <u>Reterson Bruner</u> 138 Business name License No. Address <u>Box 150 Leola, Mo</u> Signed <u>Wally Peterson</u> Date <u>11-7-75</u> <u>By RD</u> Authorized representative					

Forward the white, blue and pink copies to the Department of Health and Environment

Form WWC-5