


1 LOCATION OF WATER WELL:	Fraction	Section Number	Township Number	Range Number
County: <i>Mopla</i>	<i>Ne 1/4 Ne 1/4 Se 1/4</i>	<i>16</i>	T <i>31</i> S	R <i>2</i> EW

12 N 1 W Moundridge

Board of Agriculture, Division of Water Resources
Application Number:

4 DEPTH OF COMPLETED WELL. 66 ft. ELEVATION:

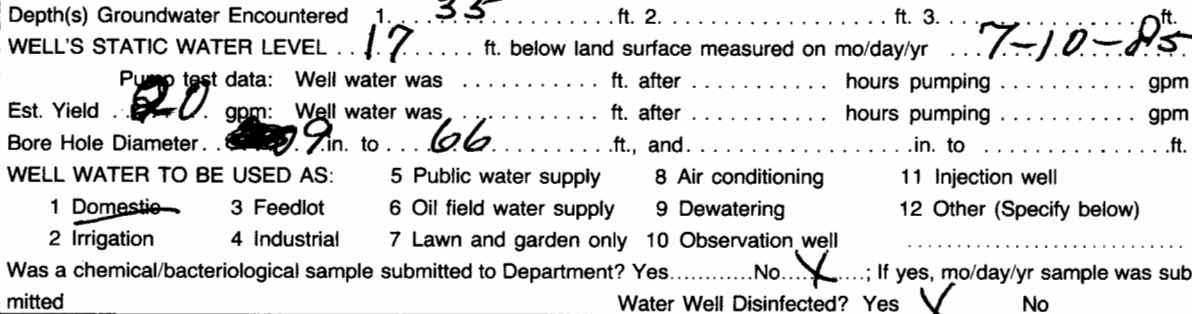

TYPE OF SCREEN OR PERFORATION MATERIAL:			7 <u>PVC</u>	10 Asbestos-cement
1 Steel	3 Stainless steel	5 Fiberglass	8 RMP (SR)	11 Other (specify)
2 Brass	4 Galvanized steel	6 Concrete tile	9 ABS	12 None used (open hole)

SCREEN-PERFORATED INTERVALS:	From <u>56</u>	ft. to <u>36</u>	ft., From	ft. to	ft.
	From	ft. to	ft., From	ft. to	ft.
GRAVEL PACK INTERVALS:	From <u>13</u>	ft. to <u>66</u>	ft., From	ft. to	ft.
	From	ft. to	ft., From	ft. to	ft.

What is the nearest source of possible contamination:

1 Septic tank	4 Lateral lines	7 Pit privy	10 Livestock pens	14 Abandoned water well
2 Sewer lines	5 Cess pool	8 <u>Sewage lagoon</u>	11 Fuel storage	15 Oil well/Gas well
3 Watertight sewer lines	6 Seepage pit	9 Feedyard	12 Fertilizer storage	16 Other (specify below)
			13 Insecticide storage

FROM	TO	LITHOLOGIC LOG	FROM	TO	LITHOLOGIC LOG
91	92	Yellow Clay			

0	20	Yellow Clay			
20	35	Fine Sand			
35	45	Red Clay			
45	55	Medium Sand			
55	66	Clay + Shale			

Water Well Contractor's License No. 120 This Water Well Record was completed on (mo/day/yr) 7-15-83
under the business name of Backhoe Drilling by (signature) [Signature]

INSTRUCTIONS: Use typewriter or ball point pen, PLEASE PRESS FIRMLY and PRINT clearly. Please fill in blanks, underline or circle the correct answers. Send top three copies to Kansas Department of Health and Environment, Division of Environment, Environmental Geology Section, Topeka, KS 66620. Send one to WATER WELL OWNER and retain one for your records.