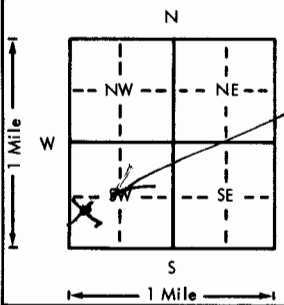


USE TYPEWRITER OR BALL
POINT PEN-PRESS FIRMLY,
PRINT CLEARLY.

WATER WELL RECORD
KSA 82a-1201-1215

Kansas Department of Health and
Environment-Division of Environment
(Water well Contractors)
Topeka, Kansas 66620

| | | | | | | | | | | | |
|---|--|--------------------------|--|---------------------------------------|--|--|--|--------------------------------|--|---|--|
| 1. Location of well: <u>McPHERSON</u> | | County: <u>McPHERSON</u> | | Fraction: <u>NW 1/4 SW 1/4 SW 1/4</u> | | Section number: <u>17</u> | | Township number: <u>T 21 S</u> | | Range number: <u>S R 2 W</u> | |
| 2. Distance and direction from nearest town or city: <u>3 WEST AND MOUNDRIDGE KS</u> Street address of well location if in city: | | | | | | 3. Owner of well: <u>DAN SCHRAAG</u> R.R. or street: <u>RR MOUNDRIDGE</u> City, state, zip code: <u>KANSAS</u> | | | | | |
| 4. Locate with "X" in section below:  | | | | | | Sketch map: <u>Irrigation Well</u> | | | | | |
| 5. Type and color of material | | | | | | From | | To | | 6. Bore hole dia. <u>32</u> in. Completion date <u>9-7-76</u> Well depth <u>137</u> ft. | |
| | | | | | | | | | | 7. <input type="checkbox"/> Cable tool <input type="checkbox"/> Rotary <input type="checkbox"/> Driven <input type="checkbox"/> Dug <input type="checkbox"/> Hollow rod <input type="checkbox"/> Jetted <input type="checkbox"/> Bored <input checked="" type="checkbox"/> Reverse rotary | |
| | | | | | | | | | | 8. Use: <input type="checkbox"/> Domestic <input type="checkbox"/> Public supply <input type="checkbox"/> Industry <input checked="" type="checkbox"/> Irrigation <input type="checkbox"/> Air conditioning <input type="checkbox"/> Stock <input type="checkbox"/> Lawn <input type="checkbox"/> Oil field water <input type="checkbox"/> Other | |
| | | | | | | | | | | 9. Casing: Material <u>IRON</u> Height: Above or below Threaded <input type="checkbox"/> Welded <input type="checkbox"/> Surface <u>12</u> in. RMP <input type="checkbox"/> PVC <input type="checkbox"/> Weight <u>38</u> lbs./ft. Dia. <u>16</u> in. to <u>137</u> ft. depth Wall Thickness: inches or Dia. <u>16</u> in. to <u>137</u> ft. depth Gauge No. <u>34</u> | |
| | | | | | | | | | | 10. Screen: Manufacturer's name <u>AUGER TIE CO</u> Type <u>TRANSITE</u> Dia. <u>16" I.D.</u> Slot/gauze <u>1/8</u> Length <u>26 FT.</u> Set between <u>111</u> ft. and <u>137</u> ft. ft. and <u>137</u> ft. Gravel pack? <u>yes</u> Size range of material <u>1/4"</u> | |
| | | | | | | | | | | 11. Static water level: <u>55</u> ft. below land surface Date <u>9-7-76</u> mo./day/yr. | |
| | | | | | | | | | | 12. Pumping level below land surfaces: <u>80</u> ft. after <u>1</u> hrs. pumping <u>800</u> g.p.m. ft. after <u> </u> hrs. pumping <u> </u> g.p.m. Estimated maximum yield <u>850</u> g.p.m. | |
| | | | | | | | | | | 13. Water sample submitted: <u> </u> mo./day/yr. Yes <input checked="" type="checkbox"/> No <input type="checkbox"/> Date <u> </u> | |
| | | | | | | | | | | 14. Well head completion: <input type="checkbox"/> Pitless adapter <u>Hook</u> Inches above grade | |
| | | | | | | | | | | 15. Well grouted? <u>yes</u> <u>grouted clay</u> With: <input type="checkbox"/> Neat cement <input type="checkbox"/> Bentonite <input type="checkbox"/> Concrete Depth: From <u>0</u> ft. to <u>10</u> ft. | |
| | | | | | | | | | | 16. Nearest source of possible contamination: <u>Well</u> ft. <u>2400</u> Direction <u>West</u> Type <u>Well</u> Well disinfected upon completion? <u> </u> Yes <input checked="" type="checkbox"/> No <input type="checkbox"/> | |
| | | | | | | | | | | 17. Pump: <u> </u> Not installed Manufacturer's name <u>WESTERN INDUSTRIAL CORP</u> Model number <u>6-17</u> HP <u>3.1</u> Volts <u> </u> Length of drop pipe <u>130</u> ft. capacity <u>800</u> g.p.m. Type: <input type="checkbox"/> Submersible <input checked="" type="checkbox"/> Turbine <input type="checkbox"/> Jet <input type="checkbox"/> Reciprocating <input type="checkbox"/> Centrifugal <input type="checkbox"/> Other | |
| 18. Elevation: | | | | | | 19. Remarks: | | | | | |
| Topography: <input type="checkbox"/> Hill <input type="checkbox"/> Slope <input checked="" type="checkbox"/> Upland <input type="checkbox"/> Valley | | | | | | 20. Water well contractor's certification: This well was drilled under my jurisdiction and this report is true to the best of my knowledge and belief. <u>PETERSON</u> <u>9-9-76</u> <u>138</u> Business name <u> </u> License No. <u> </u> Address <u>BOX 150 LINDSEY, KS</u> Signed <u>Walter Peterson</u> Date <u>9-9-76</u> Authorized representative | | | | | |

Forward the white, blue and pink copies to the Department of Health and Environment.

Form WWC-5