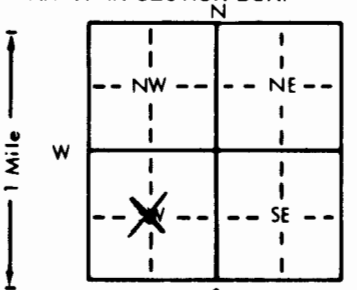


1 LOCATION OF WATER WELL:		Fraction	Section Number	Township Number	Range Number
County: McPherson		Near 1/4 Center 1/4 SW 1/4	20	T 21 S	R 2 NW
Distance and direction from nearest town or city street address of well if located within city? 3 miles West of Moundridge					
2 WATER WELL OWNER: Dave Goering					
RR#, St. Address, Box # : Rt 2					
City, State, ZIP Code : Moundridge, KS 67107					
Board of Agriculture, Division of Water Resources					
Application Number:					
3 LOCATE WELL'S LOCATION WITH AN "X" IN SECTION BOX:		4 DEPTH OF COMPLETED WELL 136 ft. ELEVATION:			
		Depth(s) Groundwater Encountered 1. 50 ft. 2. ft. 3. ft.			
		WELL'S STATIC WATER LEVEL 50 ft. below land surface measured on mo/day/yr 6-12-92			
		Pump test data: Well water was ft. after hours pumping gpm			
		Est. Yield 700 gpm: Well water was ft. after hours pumping gpm			
		Bore Hole Diameter 30 in. to 137 ft. and in. to ft.			
		WELL WATER TO BE USED AS: 5 Public water supply 8 Air conditioning 11 Injection well			
		1 Domestic 3 Feedlot 6 Oil field water supply 9 Dewatering 12 Other (Specify below)			
		2 Irrigation 4 Industrial 7 Lawn and garden only 10 Monitoring well			
		Was a chemical/bacteriological sample submitted to Department? Yes No X; If yes, mo/day/yr sample was submitted			
		Water Well Disinfected? Yes X No			
5 TYPE OF BLANK CASING USED:					
1 Steel		3 RMP (SR)	5 Wrought iron	8 Concrete tile	CASING JOINTS: Glued X Clamped
2 PVC		4 ABS	6 Asbestos-Cement	9 Other (specify below)	Welded
			7 Fiberglass		Threaded
Blank casing diameter 16 in. to 96 ft. Dia in. to ft. Dia in. to ft.					
Casing height above land surface 12 in. weight 16.15 lbs./ft. Wall thickness or gauge No. 500					
TYPE OF SCREEN OR PERFORATION MATERIAL:					
1 Steel		3 Stainless steel	5 Fiberglass	7 PVC	10 Asbestos-cement
2 Brass		4 Galvanized steel	6 Concrete tile	8 RMP (SR)	11 Other (specify)
				9 ABS	12 None used (open hole)
SCREEN OR PERFORATION OPENINGS ARE:					
1 Continuous slot		3 Mill slot	5 Gauzed wrapped	8 Saw cut	11 None (open hole)
2 Louvered shutter		4 Key punched	6 Wire wrapped	9 Drilled holes	
			7 Torch cut	10 Other (specify)	
SCREEN-PERFORATED INTERVALS: From 96 ft. to 136 ft. From ft. to ft.					
GRAVEL PACK INTERVALS: From 20 ft. to 136 ft. From ft. to ft.					
6 GROUT MATERIAL: 1 Neat cement 2 Cement grout 3 Bentonite 4 Other					
Grout Intervals: From 0 ft. to 20 ft. From ft. to ft. From ft. to ft.					
What is the nearest source of possible contamination: None within 1/4 mile					
1 Septic tank		4 Lateral lines	7 Pit privy	10 Livestock pens	14 Abandoned water well
2 Sewer lines		5 Cess pool	8 Sewage lagoon	11 Fuel storage	15 Oil well/Gas well
3 Watertight sewer lines		6 Seepage pit	9 Feedyard	12 Fertilizer storage	16 Other (specify below)
				13 Insecticide storage	
Direction from well? How many feet?					
FROM		TO		LITHOLOGIC LOG	
FROM		TO		PLUGGING INTERVALS	
0		2		Top Soil	
2		4		Gray Clay	
4		10		Brown Clay	
10		13		Gray Clay	
13		24		Tan Clay	
24		29		Tan Sandy Clay	
29		65		Medium to Fine Sand	
65		72		Tan & Gray Clay	
72		75		Medium Sand	
75		91		Gray Clay with Sand Layers	
91		106		Fine Sand	
106		115		Fine Sand with Clay layers	
115		120		Gray Clay	
120		136		Fine to Medium Sand	
136		137		Red Shale	
7 CONTRACTOR'S OR LANDOWNER'S CERTIFICATION: This water well was (1) constructed, (2) reconstructed, or (3) plugged under my jurisdiction and was completed on (mo/day/year) 6-12-92 and this record is true to the best of my knowledge and belief. Kansas					
Water Contractor's License No. 138 This Water Well Record was completed on (mo/day/yr) 6-24-92					
under the business name of Peterson Irrigation Inc. by (signature) Mike Peterson					
INSTRUCTIONS: Use typewriter or ball point pen. PLEASE PRESS FIRMLY and PRINT clearly. Please fill in blanks, underline or circle the correct answers. Send top three copies to Kansas Department of Health and Environment, Bureau of Water, Topeka, Kansas 66620-0001. Telephone: 913-296-5545. Send one to WATER WELL OWNER and retain one for your records.					