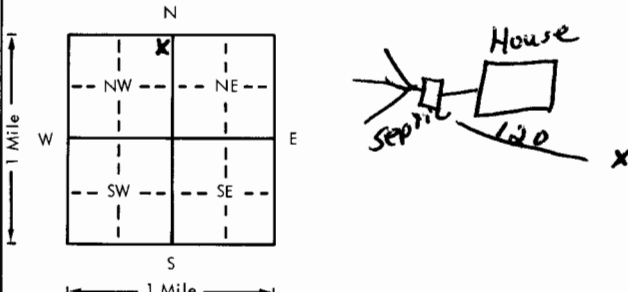


USE TYPEWRITER OR BALL
POINT PEN-PRESS FIRMLY,
PRINT CLEARLY.

WATER WELL RECORD
KSA 82a-1201-1215

Kansas Department of Health and
Environment-Division of Environment
(Water well Contractors)
Topeka, Kansas 66620

1. Location of well:	County McPherson	Fraction NE 1/4 NE 1/4 NW 1/4	Section number 22	Township number T 21 S	Range number R 2 E
2. Distance and direction from nearest town or city: 1 mi N 1/2 W of		3. Owner of well: Jim Gehring R.R. or street: 526 Park Court City, state, zip code: Moundridge, KS 67107			
4. Locate with "X" in section below: 		6. Bore hole dia. 5 1/2 in. Completion date 3-14-79 Well depth 64 ft.			
5. Type and color of material		7. <input checked="" type="checkbox"/> Cable tool <input checked="" type="checkbox"/> Rotary <input type="checkbox"/> Driven <input type="checkbox"/> Dug <input type="checkbox"/> Hollow rod <input type="checkbox"/> Jetted <input type="checkbox"/> Bored <input type="checkbox"/> Reverse rotary			
		8. Use: <input checked="" type="checkbox"/> Domestic <input type="checkbox"/> Public supply <input type="checkbox"/> Industry <input type="checkbox"/> Irrigation <input type="checkbox"/> Air conditioning <input type="checkbox"/> Stock <input type="checkbox"/> Lawn <input type="checkbox"/> Oil field water <input type="checkbox"/> Other			
		9. Casing: Material Plst Height Above or below Threaded <input type="checkbox"/> Welded <input type="checkbox"/> Surface 12 in. RMP <input checked="" type="checkbox"/> PVC <input type="checkbox"/> Weight 1.95 lbs./ft. Dia. 6 in. to 37 ft. depth Wall Thickness: inches or Dia. <input type="checkbox"/> in. to <input type="checkbox"/> ft. depth gage No. 200			
		10. Screen: Manufacturer's name Synflow Type RMP Dia. 6" <input checked="" type="checkbox"/> Slot gauze .075 Length 10 Set between 15 ft. and 25 ft. Gravel pack? Yes Size range of material F-2			
		11. Static water level: 6 ft. below land surface Date 3-14-79 mo./day/yr.			
		12. Pumping level below land surfaces: 60 ft. after 10 hrs. pumping 5 g.p.m. ft. after hrs. pumping g.p.m. Estimated maximum yield 5 g.p.m.			
		13. Water sample submitted: mo./day/yr. Yes <input checked="" type="checkbox"/> No <input type="checkbox"/> Date			
		14. Well head completion: Pitless adapter 12 inches above grade			
		15. Well grouted? Yes With: <input checked="" type="checkbox"/> Neat cement <input type="checkbox"/> Bentonite <input type="checkbox"/> Concrete Depth: From 3 ft. to 8 ft.			
		16. Nearest source of possible contamination: ft. 120 Direction W Type Septic Well disinfected upon completion? <input checked="" type="checkbox"/> Yes <input type="checkbox"/> No			
		17. Pump: <input checked="" type="checkbox"/> Not installed Manufacturer's name Model number HP Volts Length of drop pipe ft. capacity g.p.m. Type: <input type="checkbox"/> Submersible <input type="checkbox"/> Turbine <input type="checkbox"/> Jet <input type="checkbox"/> Reciprocating <input type="checkbox"/> Centrifugal <input type="checkbox"/> Other			
18. Elevation:		19. Remarks: 10" to 37' 5" From 37 to 64			
Topography: <input type="checkbox"/> Hill <input type="checkbox"/> Slope <input checked="" type="checkbox"/> Upland <input type="checkbox"/> Valley		20. Water well contractor's certification: This well was drilled under my jurisdiction and this report is true to the best of my knowledge and belief. Miller Water Well 137 Business name License No. Address Hutchinson, KS Signed Egon Miller Date 5-16-79 Authorized representative			

Forward the white, blue and pink copies to the Department of Health and Environment

Form WWC-5