


1 LOCATION OF WATER WELL: Fraction NW 1/4 NW 1/4 SW 1/4 Section Number 24 Township Number T 21 S Range Number R 2 E
 County: Mcpherson
 Distance and direction from nearest town or city street address of well if located within city?

1 East 1/2 North of Moundridge

2 WATER WELL OWNER: Myron Fensky
 RR#, St. Address, Box #: RR #2
 City, State, ZIP Code: Moundridge, KS 67107
 Board of Agriculture, Division of Water Resources
 Application Number:

3 LOCATE WELL'S LOCATION WITH AN "X" IN SECTION BOX: 4 DEPTH OF COMPLETED WELL: ft. ELEVATION:

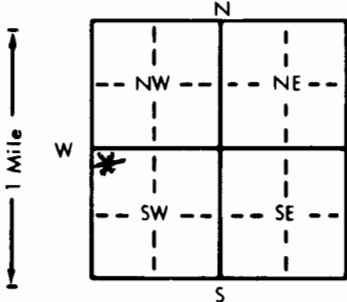

Depth(s) Groundwater Encountered 1. 12 ft. 2. 12 ft. 3. 12 ft.
 WELL'S STATIC WATER LEVEL 12 ft. below land surface measured on mo/day/yr 6-4-86
 Pump test data: Well water was 14 ft. after 2 hours pumping 30 gpm
 Est. Yield 30 gpm: Well water was 14 ft. after 2 hours pumping 30 gpm
 Bore Hole Diameter 1 1/2 in. to 37 ft., and 37 ft. to 37 ft.
 WELL WATER TO BE USED AS: 5 Public water supply 8 Air conditioning 11 Injection well
1 Domestic 3 Feedlot 6 Oil field water supply 9 Dewatering 12 Other (Specify below)
 2 Irrigation 4 Industrial 7 Lawn and garden only 10 Observation well
 Was a chemical/bacteriological sample submitted to Department? Yes X No X; If yes, mo/day/yr sample was submitted
 Water Well Disinfected? Yes No

5 TYPE OF BLANK CASING USED: 5 Wrought iron 8 Concrete tile CASING JOINTS: Glued X Clamped X
 1 Steel 3 RMP (SR) 6 Asbestos-Cement 9 Other (specify below) Welded X
2 PVC 4 ABS 7 Fiberglass Threaded X

Blank casing diameter 5 in. to 26 ft., Dia. 26 in. to 26 ft., Dia. 26 in. to 26 ft.
 Casing height above land surface 18 in., weight 2.37 lbs./ft. Wall thickness or gauge No. 214

TYPE OF SCREEN OR PERFORATION MATERIAL: 7 PVC 10 Asbestos-cement
 1 Steel 3 Stainless steel 5 Fiberglass 8 RMP (SR) 11 Other (specify)
 2 Brass 4 Galvanized steel 6 Concrete tile 9 ABS 12 None used (open hole)

SCREEN OR PERFORATION OPENINGS ARE: 5 Gauzed wrapped .031 8 Saw cut factory 11 None (open hole)
 1 Continuous slot 3 Mill slot 6 Wire wrapped 9 Drilled holes
 2 Louvered shutter 4 Key punched 7 Torch cut 10 Other (specify)

SCREEN-PERFORATED INTERVALS: From 26 ft. to 36 ft., From 36 ft. to 36 ft., From 36 ft. to 36 ft.
 GRAVEL PACK INTERVALS: From 10 ft. to 37 ft., From 37 ft. to 37 ft., From 37 ft. to 37 ft.

6 GROUT MATERIAL: 1 Neat cement 2 Cement grout 3 Bentonite 4 Other
 Grout Intervals: From 0 ft. to 10 ft., From 10 ft. to 10 ft., From 10 ft. to 10 ft.

What is the nearest source of possible contamination: 10 Livestock pens 14 Abandoned water well
 1 Septic tank 4 Lateral lines 7 Pit privy 11 Fuel storage 15 Oil well/Gas well
 2 Sewer lines 5 Cess pool 8 Sewage lagoon 12 Fertilizer storage 16 Other (specify below)
 3 Watertight sewer lines 6 Seepage pit 9 Feedyard 13 Insecticide storage

Direction from well? SW How many feet? 200'

FROM	TO	LITHOLOGIC LOG	FROM	TO	LITHOLOGIC LOG
0	5	loam to br. clay			
5	10	red brw clay			
10	12	Sandy clay			
12	20	med Sand - brown			
20	22	red brown clay			
22	29	med coarse sand			
29	31	blue gray clay			
31	36	med fine to coarse sand			
36	38	red-green shale to gray			

7 CONTRACTOR'S OR LANDOWNER'S CERTIFICATION: This water well was (1) constructed (2) reconstructed, or (3) plugged under my jurisdiction and was completed on (mo/day/year) 6-5-86 and this record is true to the best of my knowledge and belief. Kansas

Water Well Contractor's License No. 543 This Water Well Record was completed on (mo/day/yr) 6-28-86
 under the business name of Under water well & pump by (signature) Paul Brumhart

INSTRUCTIONS: Use typewriter or ball point pen, PLEASE PRESS FIRMLY and PRINT clearly. Please fill in blanks, underline or circle the correct answers. Send top three copies to Kansas Department of Health and Environment, Division of Environment, Environmental Geology Section, Topeka, KS 66620. Send one to WATER WELL OWNER and retain one for your records.