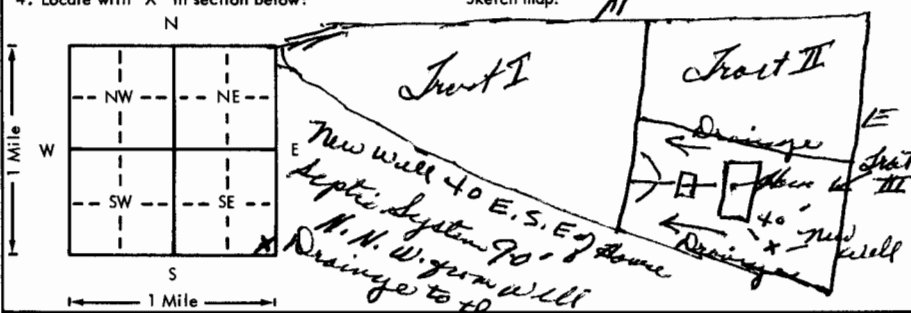


USE TYPEWRITER OR BALL
POINT PEN-PRESS FIRMLY,
PRINT CLEARLY.

WATER WELL RECORD
KSA 82a-1201-1215

Kansas Department of Health and
Environment-Division of Environment
(Water well Contractors)
Topeka, Kansas 66620

1. Location of well: County <u>McPherson</u> Fraction <u>SE 1/4 SE 1/4 SW 1/4</u> Section number <u>26</u> Township number <u>T 21 S</u> Range number <u>R 2</u> (W)			
2. Distance and direction from nearest town or city: <u>1/2 E. SE along Hwy 81. Moundridge Kans.</u> Street address of well location if in city: _____		3. Owner of well: <u>Richard L. Gardner</u> R.R. or street: _____ City, state, zip code: <u>Moundridge, Kan 67107</u>	
4. Locate with "X" in section below: Sketch map: <u>N</u> 		6. Bore hole dia. <u>3</u> in. Completion date <u>12-2-75</u> Well depth <u>38</u> ft.	
5. Type and color of material		7. <input checked="" type="checkbox"/> Cable tool <input checked="" type="checkbox"/> Rotary <input type="checkbox"/> Driven <input type="checkbox"/> Dug <input type="checkbox"/> Hollow rod <input type="checkbox"/> Jetted <input type="checkbox"/> Bored <input type="checkbox"/> Reverse rotary	
8. Use: <input checked="" type="checkbox"/> Domestic <input type="checkbox"/> Public supply <input type="checkbox"/> Industry <input type="checkbox"/> Irrigation <input type="checkbox"/> Air conditioning <input type="checkbox"/> Stock <input type="checkbox"/> Lawn <input type="checkbox"/> Oil field water <input type="checkbox"/> Other			
9. Casing: Material <u>plst</u> Height: <u>Above</u> or below Threading: <u>Welded</u> Surface <u>18</u> in. RMP: <u>PVC</u> Weight <u>18</u> lbs./ft. Dia. <u>5</u> in. to <u>38</u> ft. depth Wall Thickness: inches or Dia. <u>5</u> in. to <u>38</u> ft. depth gage No. <u>14</u>			
10. Screen: Manufacturer's name <u>Jet Stream</u> <u>Walsh Bros. Co.</u> Type <u>PVC</u> Dia. <u>5</u> Slot/gauze <u>1/16</u> Length <u>20 ft.</u> Set between <u>18</u> ft. and <u>38</u> ft. Gravel pack? <u>Yes</u> Size range of material <u>1/4-1/8</u>			
11. Static water level: <u>12-6</u> ft. below land surface Date <u>12-2-75</u>		12. Pumping level below land surfaces: <u>23</u> ft. after <u>2</u> hrs. pumping <u>8</u> g.p.m. _____ ft. after _____ hrs. pumping _____ g.p.m. Estimated maximum yield <u>10</u> g.p.m.	
13. Water sample submitted: _____ mo./day/yr. <input type="checkbox"/> Yes <input checked="" type="checkbox"/> No Date _____		14. Well head completion: <input checked="" type="checkbox"/> Pitless adapter <u>18</u> inches above grade	
15. Well grouted? <u>yes</u> With: <input checked="" type="checkbox"/> Neat cement <input type="checkbox"/> Bentonite <input type="checkbox"/> Concrete Depth: From <u>4</u> ft. to <u>15</u> ft.			
16. Nearest source of possible contamination: ft. <u>Sept</u> Direction <u>N.W.</u> Type <u>Septic</u> Well disinfected upon completion? <input checked="" type="checkbox"/> Yes <input type="checkbox"/> No			
17. Pump: <input checked="" type="checkbox"/> Not installed Manufacturer's name <u>Migros</u> Model number <u>22450</u> HP <u>1/2</u> Volts <u>230</u> Length of drop pipe <u>30</u> ft. capacity <u>8</u> g.p.m. Type: <input checked="" type="checkbox"/> Submersible <input type="checkbox"/> Turbine <input type="checkbox"/> Jet <input type="checkbox"/> Reciprocating <input type="checkbox"/> Centrifugal <input type="checkbox"/> Other			
18. Elevation: _____		20. Water well contractor's certification: This well was drilled under my jurisdiction and this report is true to the best of my knowledge and belief. <u>Peterson, Brian</u> 138 Business name _____ License No. _____ Address <u>Box 150 Leavenworth</u> Signed <u>Walsh Bros.</u> Date <u>12-2-75</u> By <u>T.D.</u> Authorized representative	
19. Remarks: <u>Mr. Gardner will have a 4 ft. sq. slab poured around the well which he has the pump installed.</u> <u>He knows the law.</u>			

Forward the white, blue and pink copies to the Department of Health and Environment

Form WWC-5