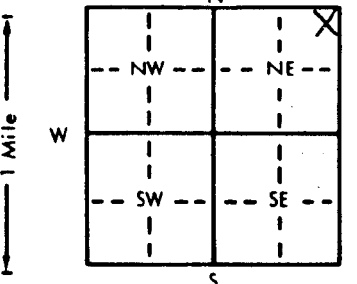


1 LOCATION OF WATER WELL: County: McPherson		Fraction NE 1/4 NW 1/4 NE 1/4		Section Number 27	Township Number T 21 S	Range Number R 2 EW
Distance and direction from nearest town or city street address of well if located within city? 124 Drucilla, Moundridge, Ks.						
2 WATER WELL OWNER: Mid Kansas Coop RR#, St. Address, Box # : 124 Drucilla City, State, ZIP Code : Moundridge, Ks. Board of Agriculture, Division of Water Resources Application Number:						
3 LOCATE WELL'S LOCATION WITH AN "X" IN SECTION BOX: 		4 DEPTH OF COMPLETED WELL: 29 ft. ELEVATION: ft. Depth(s) Groundwater Encountered 1. 18 ft. 2. ft. 3. ft. WELL'S STATIC WATER LEVEL: ft. below land surface measured on mo/day/yr Pump test data: Well water was ft. after hours pumping gpm Est. Yield gpm: Well water was ft. after hours pumping gpm Bore Hole Diameter 7 5/8 in. to 29 ft., and in. to ft. WELL WATER TO BE USED AS: 5 Public water supply 8 Air conditioning 11 Injection well 1 Domestic 3 Feedlot 6 Oil field water supply 9 Dewatering 12 Other (Specify below) 2 Irrigation 4 Industrial 7 Lawn and garden only (10) Monitoring well Was a chemical/bacteriological sample submitted to Department? Yes.....No ☒ ; If yes, mo/day/yr sample was submitted Water Well Disinfected? Yes No ☒				
5 TYPE OF BLANK CASING USED: 1 Steel 3 RMP (SR) 5 Wrought iron 8 Concrete tile CASING JOINTS: Glued Clamped (2) PVC 4 ABS 6 Asbestos-Cement 9 Other (specify below) Welded Blank casing diameter 2 in. to 9 ft., Dia in. to ft., Dia in. to ft. Casing height above land surface 0 in., weight lbs./ft. Wall thickness or gauge No. Sch. 40 TYPE OF SCREEN OR PERFORATION MATERIAL: 1 Steel 3 Stainless steel 5 Fiberglass (7) PVC 10 Asbestos-cement 2 Brass 4 Galvanized steel 6 Concrete tile 8 RMP (SR) 11 Other (specify) 9 ABS 12 None used (open hole) SCREEN OR PERFORATION OPENINGS ARE: 1 Continuous slot (3) Mill slot 5 Gauzed wrapped 8 Saw cut 11 None (open hole) 2 Louvered shutter 4 Key punched 6 Wire wrapped 9 Drilled holes 7 Torch cut 10 Other (specify) SCREEN-PERFORATED INTERVALS: From 29 ft. to 9 ft., From ft. to ft. From ft. to ft., From ft. to ft. GRAVEL PACK INTERVALS: From 29 ft. to 7 ft., From ft. to ft. From ft. to ft., From ft. to ft.						
6 GROUT MATERIAL: 1 Neat cement (2) Cement grout (3) Bentonite 4 Other Grout Intervals: From 0 ft. to 5 ft., From 5 ft. to 7 ft., From ft. to ft. What is the nearest source of possible contamination: 1 Septic tank 4 Lateral lines 7 Pit privy (11) Fuel storage 14 Abandoned water well 2 Sewer lines 5 Cess pool 8 Sewage lagoon 12 Fertilizer storage 15 Oil well/Gas well 3 Watertight sewer lines 6 Seepage pit 9 Feedyard 13 Insecticide storage 16 Other (specify below) Direction from well? northeast How many feet? 440						
FROM		TO		LITHOLOGIC LOG		FROM
0		6"		MD BRN TOPSOIL		TO
6"		4'		V DK BRN CLY, SL SLTY, ORG MAT		PLUGGING INTERVALS
4'		8'		MD BRN CLY, MOD SLTY, TR SND-GRVL SZ PART		MW7
8		14		LT GRY CLY, TR F SND, TR OXID ROOT, V SLTY		FLUSH MOUNT COVER
14		29		RD BRN CLY MOTT, LT GRY, W DK BRN CARBONAC MAT, M TO V SLTY		
7 CONTRACTOR'S OR LANDOWNER'S CERTIFICATION: This water well was (1) constructed, (2) reconstructed, or (3) plugged under my jurisdiction and was completed on (mo/day/year) 08-24-93 and this record is true to the best of my knowledge and belief. Kansas Water Well Contractor's License No. 527 This Water Well Record was completed on (mo/day/yr) 10-11-93 under the business name of GeoCore Services, Inc. by (signature) Dale Bell						
INSTRUCTIONS: Use typewriter or ball point pen. PLEASE PRESS FIRMLY and PRINT clearly. Please fill in blanks, underline or circle the correct answers. Send top three copies to Kansas Department of Health and Environment, Bureau of Water, Topeka, Kansas 66620-0001. Telephone: 913-296-5545. Send one to WATER WELL OWNER and retain one for your records.						