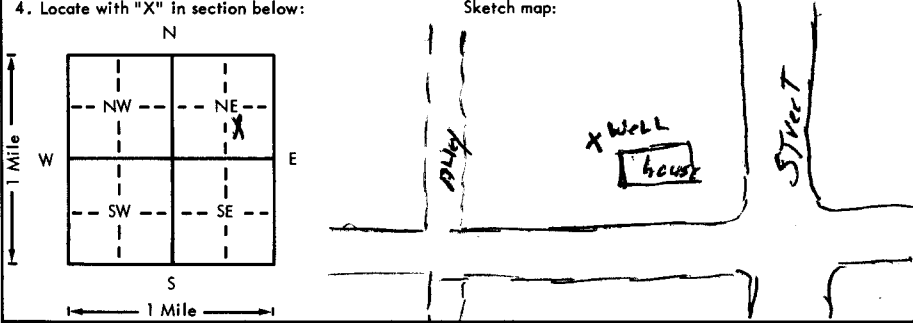


USE TYPEWRITER OR BALL
POINT PEN-PRESS FIRMLY,
PRINT CLEARLY.

WATER WELL RECORD
KSA 82a-1201-1215

Kansas Department of Health and
Environment-Division of Environment
(Water well Contractors)
Topeka, Kansas 66620

1. Location of well:		County McPherson	Fraction NE 1/4 SE 1/4 NE 1/4	Section number 27	Township number T 21 S R 2 E	Range number 2
2. Distance and direction from nearest town or city: Street address of well location if in city: SAME				3. Owner of well: ALLEN JANZEN R.R. or street: 701 S. Edwards City, state, zip code: Mountville, KANSAS		
4. Locate with "X" in section below:		Sketch map:		6. Bore hole dia. 10 in. Completion date 5/20/76 Well depth 33 ft.		
				7. <input checked="" type="checkbox"/> Cable tool <input checked="" type="checkbox"/> Rotary <input type="checkbox"/> Driven <input type="checkbox"/> Dug <input type="checkbox"/> Hollow rod <input type="checkbox"/> Jetted <input type="checkbox"/> Bored <input type="checkbox"/> Reverse rotary		
5. Type and color of material				8. Use: <input type="checkbox"/> Domestic <input type="checkbox"/> Public supply <input type="checkbox"/> Industry <input checked="" type="checkbox"/> Irrigation <input type="checkbox"/> Air conditioning <input type="checkbox"/> Stock <input checked="" type="checkbox"/> Lawn <input type="checkbox"/> Oil field water <input type="checkbox"/> Other		
				9. Casing: Material PVC Height: Above or below Threaded <input type="checkbox"/> Welded <input checked="" type="checkbox"/> Surface 12 in. RMP <input type="checkbox"/> PVC <input checked="" type="checkbox"/> Weight 15 lbs./ft. Dia 5 in. to 33 ft. depth Wall Thickness: inches or Dia. 5 in. to 33 ft. depth gage No. 33		
				10. Screen: Manufacturer's name Robin-Tech - even slot Type PVC Dia. 5" Slot/gauze .064 Length 15' Set between 15' ft. and 30' ft. Gravel pack? <input checked="" type="checkbox"/> Size range of material 10-14		
				11. Static water level: 14 ft. below land surface Date 5/20/76		
				12. Pumping level below land surfaces: 17 ft. after 1 hrs. pumping 20 g.p.m. ft. after 2 hrs. pumping 20 g.p.m. Estimated maximum yield 20 g.p.m.		
				13. Water sample submitted: Yes <input checked="" type="checkbox"/> No <input type="checkbox"/> Date 5/20/76		
				14. Well head completion: <input type="checkbox"/> Pitless adapter 12 inches above grade		
				15. Well grouted? <input checked="" type="checkbox"/> With: <input checked="" type="checkbox"/> Neat cement <input type="checkbox"/> Bentonite <input type="checkbox"/> Concrete Depth: From 12 ft. to 33 ft.		
				16. Nearest source of possible contamination: ft. 110 Direction Souther Type Souther Well disinfected upon completion? <input type="checkbox"/> Yes <input checked="" type="checkbox"/> No		
				17. Pump: <input checked="" type="checkbox"/> Not installed Manufacturer's name PAULIS INC Model number 125 HP 1/2 Volts 115 Length of drop pipe 125 ft. capacity 1/2 g.p.m. Type: <input type="checkbox"/> Submersible <input type="checkbox"/> Turbine <input type="checkbox"/> Jet <input type="checkbox"/> Reciprocating <input type="checkbox"/> Centrifugal <input type="checkbox"/> Other		
				20. Water well contractor's certification: This well was drilled under my jurisdiction and this report is true to the best of my knowledge and belief. PAULIS INC License No. 125 Address HESSTON, KANSAS Signed Paul Budinski Date 6/13/76 Authorized Representative		
18. Elevation:		19. Remarks: YD. Irrigation well				

Forward the white, blue and pink copies to the Department of Health and Environment

Form WWC-5